
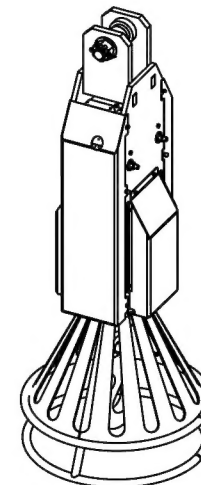
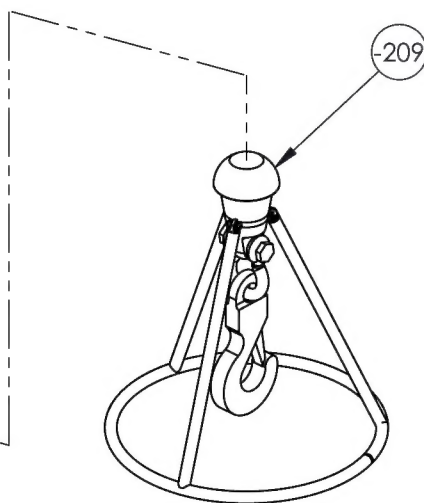


This drawing, specifications, and concepts contained here in are the sole property of Dart Aerospace, and may not be reproduced or used in any fashion without the prior written permission of Dart Aerospace Eugene, OR.

REVISIONS					
REV	ECR	DESCRIPTION	DATE	INITIAL	APPROVED
1	15-0005	-5, -9 REMOVED 2 HOLES USED WITH -59, -7 CHG MATERIAL 4140/4142. -15 INCREASED WIDTH BY .06 TO 6.40. -55, -57 MOVED HOLES FROM 16.91 TO 17.91. -59 REMOVED 2 HOLES, INCREASED LENGTH TO 17.44 FROM 15.44.	1/6/2015	PW	JG
2	15-0149	UPDATED TO NEW DRAFTING STANDARDS. -3 ADDED NOTE 4. -5 DELETED HOLES D1, D2, D3, D4. ADDED HOLES C7, C8. -9 DELETED HOLES E1, E2, E3, E4. ADDED HOLES D7, D8. -29 CH'D BORE DIA WAS LIMITS Ø.7518-7513 IS LIMITS Ø.8768-.8763. REMOVED COUNTERSINKS. -33 CH'D ROD DIA WAS LIMITS Ø.6240-.6230 IS LIMITS Ø.7495-.7483. -49 CH'D TITLEBLOCK TOLERANCES. -55 ADDED CHAMFER 2X .30 X 45°. DELETED HOLES 4X Ø.194. ADDED HOLES 2X Ø.28. ADDED TAB. -57 ADDED CHAMFER 2X .30 X 45°. DELETED HOLES 4X Ø.194. ADDED HOLES 2X Ø.28. ADDED TAB. -59 HOLES SLOTTED. FLANGE INTERFACE IMPROVED. -59A CH'D DIM WAS 2X 7.643 IS 7.643. ADDED DIM 7.513. -61 CH'D HOLE LOCATION WAS 2.00 IS 1.85. WAS 2.60 IS 2.30. ADDED KNOB -239 . -65 CH'D DIM WAS Ø1.10 $\sqrt{.03}$ IS 2X Ø1.10 $\sqrt{.025}$. -79 ADDED 4X -231 , 4X -233 , 4X -235 . -79E UPDATED WIRE TABLE AS BUILT. CH'D T3-T4 QD TO T3 BUTT SPLICE. ADDED T11 BUTT SPLICE. ADDED T12-T13 QD. -81 CH'D QTY WAS 1 IS 2. -93A CH'D HOLE LOCATIONS, A1 WAS 1.20 IS 1.09, A2 WAS 4.20 IS 4.31, A3 WAS 2.10 IS 1.99, A4 WAS 5.10 IS 5.21, C3 WAS 1.56 IS 1.59, C4 WAS 6.00 IS 6.08. CH'D HOLE DIA WAS Ø.13 IS Ø.15. -93B CH'D HOLE LOCATIONS A1 WAS 1.56 IS 1.59, A2 WAS 4.23 IS 4.15. ADDED MISSING HOLE THREADS 4X 4-40. CH'D HOLE DIM WAS .75 IS .64. CH'D TOL WAS .87 IS .870. -121 CH'D B/O INFO WAS E-SWITCH IS CIT SWITCH. -153 SIZE INCREASED TO 3/4. -171 WAS FLATHEAD IS SHCS. -193, -195, -199, -201 DELETED. -219 CH'D TOL WAS .51 IS .510. -221 CH'D TOL WAS (.50) IS .500. ADDED -229, -231, -233, -235, -237, -239, -239 ADDED DRAWING SHHET.	6/22/2015	PMW	JAG

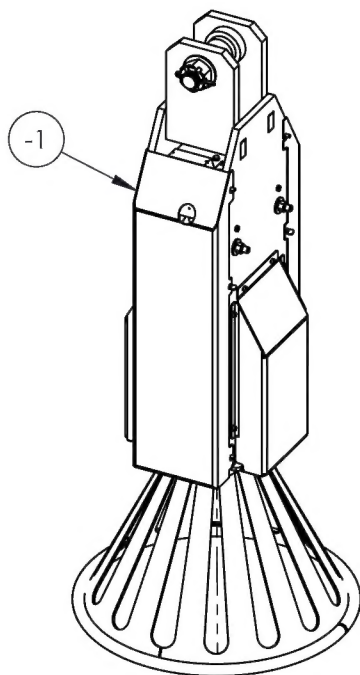

NOTES:
 TBD: ANTENNA POSITION.
 OPERATOR ON GROUND OR IN HELICOPTER?
 MAYBE ADD MULTIPLE ANTENNAS.
 TBD: THUMB SCREWS FOR THE COVERS.
 IS THERE A BETTER METHOD?



DART AEROSPACE	
TITLE VERTICAL CAPTURE TRANSPORT	
DWG NO. VCT-3	REV 2
MAT'L UNLESS OTHERWISE SPECIFIED DIMENSIONS ARE IN INCHES .XXX ± .005 FRACTIONS ± 1/8 .XX ± .01 ANGLES ± 5° .X ± .1	DRAWN BY: GILBERT APPROVED <i>J Gilbert</i> HEAT TREAT FINISH SPEC
1. BREAK ALL SHARP EDGES .015 x 45° OR .015R 2. DIMENSIONAL LIMITS APPLY AFTER PLATING	
SCALE 1:16	DATE 12/3/2014
SHEET 1 OF 57	


This drawing, specifications, and concepts contained here in are the sole property of Dart Aerospace, and may not be reproduced or used in any fashion without the prior written permission of Dart Aerospace Eugene, OR.

-209	-211	-93	-79	-67	-63	-61	-21	-3	-1	B/O	Part #	UNIT QTY	Description	Material	B/O INFORMATION OR SPECIFICATIONS	PG.
								X	1		-1	1	VCT HOOK ASSEMBLY			3
							X	1			-3		FRAME WELDMENT			4
								1			-5		FRAME	HR P&O		
								1			-7		PLATFORM	4140/4142		
								1			-9		OPEN HOLE FRAME	HR P&O		
								1			-11		FRAME FLANGE	HR P&O		
								4			-13		BOSS, HOOK	A36		
								2			-15		LIFTING PLATE	HR P&O		
								2			-17		LIFTING BOSS	A36		
								8		B/O	-19		DOWEL PIN	S.S.	Ø1/4 X 1 (MCMaster-CARR #97395A491)	
							X		1		-21		CONE WELDMENT			
								1			-23		CONE RING	C.D.S. 1018		
								1			-25		CONE FLANGE	A36		
								1			-27		CONE	HR PLATE		
											-27A		CONE FLAT PATTERN			
								1			-29		MAIN RING	4140/4142		
								1			-31		CROSS	4140/4142		
								1			-33		PUSH ROD	4140/4142 Q&T		
								1			-35		PUSH ROD LINK	4140/4142		
									2		-37		PIN, PUSH ROD LINK	4140/4142 Q&T		
								6			-39		LINK	4140/4142		
								12			-41		PIN, LINK	4140/4142 Q&T		
								6			-43		ARM	4140/4142		
								6			-45		PIN, ARM	4140/4142 Q&T		
								6			-47		ANCHOR GUARD	6061		
								2			-49		BRACKET, BOX	1018		
								1			-51		LIFTING BUSHING	4140/4142 Q&T		
								1			-53		LIFTING BOLT	STEEL	1-1/2 - 6 X 8, GRADE 8 (MCMaster-CARR # 91268A963) MODIFIED	
								1			-55		COVER	1018		
											-55A		COVER FLAT PATTERN			
								1			-57		COVER	1018		
											-57A		COVER FLAT PATTERN			
									2		-59		SIDE COVER	1018		
											-59A		SIDE COVER FLAT PATTERN			
									1		-61		C45 VCT-3 HOOK ASSEMBLY			
													C45			
											-63		LOAD BEAM ASSY			
											-65		LOAD BEAM	4140/4142		
													C45-4-2	TRUNNION	4140	
											-67		CABLE HARNESS			
									1		-69		PLUG		MS3106R14S6P (ALLIED # 70010122)	
									2		-71		KNIFE CONNECTOR		22-16 AWG (ALLIED # 70082802)	
									1		-73		PROXIMITY SWITCH		INDUCTIVE M5 AUTOMATION-DIRECT# PD1-AP-3A	
									1		-75		HEAT SHRINK TUBE	RUBBER	Ø1/4 BLACK (MCMaster-CARR# 7856K17)	
									1		-77		WIRE 16AWG		6 FT WIRE 16AWG	
											-79		ELECTRICAL ASSEMBLY			
											-79E		WIRING DIAGRAM			
									2		-81		BLOCK, BATTERY	6061		
									1		-83		ELECTRICAL PORT PLATE	6061		
									1		-85		ELECTRICAL PORT GASKET	NEOPRENE RUBBER	1/16 x 3-1/2 x 5 W/ADHESIVE BACK (MCMaster-CARR # 8461K42)	
									1		-87		ANTENNA BLOCK	6061		
									1		-89		GASKET, ANTENNA BLOCK	BUNA-N RUBBER	1/16 X 1-3/8 X 2-1/8 (GASKET SPECIALTIES)	
									1		-91		PLATE LIGHT ELECTRONICS	6061		
											-93		ENCLOSURE	ALUMINUM	AN-1323 BUD (ALLIED #70147983)	
											-93A		LID, ENCLOSURE	ALUMINUM	MODIFIED	
									1		-93B		BOX, ENLOSURE	ALUMINUM	MODIFIED	
											-95		HEX HEAD CAP SCREW	S.S.	1/4-20 X 3/4 (MCMaster-CARR# 92240A540)	
											-97		SOCKET HEAD CAP SCREW	S.S.	10-24 X 1 (MCMaster-CARR# 92185A247)	
											-99		THUMB SCREW	S.S.	#8-32 X 3/8 (MCMaster-CARR# 91744A192)	
											-101		HEX HEAD CAP SCREW	S.S.	1/4-20 X 4-1/4 (MCMaster-CARR# 92198A559)	
											-103		BUTTON HEAD SCREW	S.S.	4-40 X 7/16 (MCMaster-CARR# 92949A111)	
											-105		HELICOIL	S.S.	8-32 X .164 (MCMaster-CARR# 91732A359)	
									3		-107		NYLON INSERT HEX NUT	S.S.	1/4-20 (MCMaster-CARR #91831A029)	
											-109		WASHER	S.S.	1/4 (MCMaster-CARR #96659A106)	
											-111		GASKET, RECEPTACLE	RUBBER	10-040450-014 (ALLIED# 70010390)	
											-113		SEALING WASHER		Ø1/4 (MCMaster-CARR# 93783A029)	
											-115		SPACER	NYLON	#4 X 1/4 (MCMaster-CARR# 94639A201)	
											-117		ELECTRICAL RECEPTACLE		MS3102R14S6S (ALLIED# 70143519)	
											-119		LIGHT SWITCH		APEM ISR3SAD200 (ALLIED# 70066003)	
											-121		SWITCH		CIT# CH1LFS024S	
											-123		STROBE LIGHT		12V LIGHT, CLEAR (SPEEDTECHLIGHTS# STL Z-3, CLEAR)	
											-125		VOLTAGE REGULATOR		RECOM R-78B12-1.0 (ALLIED# 70051995)	
											-127		RELAY		OMRON 12V G5LA (ALLIED# 70175858)	
											-129		ANTENNA		433 MHZ 1/4 WAV WHIP RPSMA (DIGI-KEY #ANT-433-CW-HW-ND)	
											-131		BATTERY		24V ULTRALIFE #UBBL09/B	
											-133		BATTERY CONNECTOR		24V ULTRALIFE #CA0006	
											-135		CIRCUIT BOARD, RECEIVER		BERRY INDUSTRIES #BIDA001RE	
											-137		CIRCUIT BOARD, POWER		BERRY INDUSTRIES #BIDA001PW	


-209	-211	-93	-79	-67	-63	-61	-21	-3	-1	B/O	Part #	UNIT QTY	Description	Material	B/O INFORMATION OR SPECIFICATIONS	PG.
			2							B/O	-138		BUTT SPLICE		16-14 AWG HEAT SHRINK (MCMMASTER-CARR# 7617K13)	
			4							B/O	-139		CONNECTOR		QD TERMINAL MALE (MCMMASTER-CARR# 7243K22)	
			6							B/O	-141		CONNECTOR		QD TERMINAL FEMALE (MCMMASTER-CARR# 7243K21)	
			1							B/O	-143		WIRE		6FT WIRE 22AWG	
									12	B/O	-145		THRUST BEARING	BRONZE	Ø1/2 I.D. X Ø3/4 O.D. X 1/16 (SYMMCO #ST-1624-2)	
									1	B/O	-147		WASHER	STEEL	Ø5/8, GRADE 8 (MCMMASTER-CARR# 98023A035)	
									2	B/O	-149		HEX NUT	STEEL	5/8-18, GRADE 8 THIN (MCMMASTER-CARR# 93839A835)	
									1	B/O	-151		DIE SPRING	STEEL	2 LONG X 1.25 HOLE X 5/8 ROD (MCMMASTER-CARR# 9573K67)	
									1	B/O	-153		BUSHING	SINTERED BRONZE	Ø3/4 I.D. X Ø7/8 O.D. X 1 (SYMMCO #SF-2428-16)	
									2	B/O	-155		WASHER	STEEL	1-1/2 (MCMMASTER-CARR# 90126A042)	
									1	B/O	-157		SLOTTED NUT	STEEL	1-1/2 - 6 (MCMMASTER-CARR# 95030A370)	
									12	B/O	-159		BOLT	S.S.	1/4-20 X 3-1/4 (MCMMASTER-CARR #92198A555)	
									12	B/O	-161		SLEEVE BEARING	SINTERED BRONZE	Ø3/8 X 1/2 OD X 1/2 (SYMMCO SS-1216-8)	
									2	B/O	-163		SLEEVE BEARING	SINTERED BRONZE	Ø5/8 X 3/4 OD X 3/4 (SYMMCO SS-2024-12)	
									6	B/O	-165		SLEEVE BEARING	SINTERED BRONZE	Ø1/2 X 5/8 OD X 1/2 (SYMMCO SS-1620-8)	
									24	B/O	-167		THRUST BEARING	BRONZE	Ø3/8 I.D. X 5/8 O.D. X 1/16 (SYMMCO #ST-1220-2)	
									4	B/O	-169		THRUST BEARING	BRONZE	Ø21/32 I.D. X Ø1-1/2 O.D. X 1/16 (SYMMCO #ST-2148-2)	
									4	B/O	-171		SOCKET HEAD CAP SCREW	S.S.	1/4-20 X 1-1/2 LOW PROFILE (MCMMASTER-CARR# 93615A425)	
									4	B/O	-173		WASHER	STEEL	Ø1/2 (MCMMASTER-CARR# 90108A033)	
									2	B/O	-175		HEX HEAD CAP SCREW	STEEL	1/2-13 X 9, GRADE 8 (MCMMASTER-CARR# 91257A742)	
									2	B/O	-177		NYLON INSERT HEX NUT	STEEL	1/2-13, GRADE 8 (MCMMASTER-CARR #97135A250)	
									4	B/O	-179		PAN HEAD SCREW	S.S.	10-24 X 3/4 (MCMMASTER-CARR #91772A245)	
									4	B/O	-181		NYLON INSERT HEX NUT	S.S.	10-24 (MCMMASTER-CARR #91831A011)	
									4	B/O	-183		WASHER	S.S.	#10 (MCMMASTER-CARR #96659A104)	
									4	B/O	-185		HEX HEAD CAP SCREW	S.S.	1/4-20 X 1-1/4 (MCMMASTER-CARR #92198A544)	
									1	B/O	-187		COTTER PIN	STEEL	Ø1/4 X 3 (MCMMASTER-CARR #98338A554)	
									2	B/O	-189		COTTER PIN	STEEL	Ø1/8 X 1 (MCMMASTER-CARR #98338A475)	
									18	B/O	-191		COTTER PIN	STEEL	Ø3/32 X 3/4 (MCMMASTER-CARR #98338A441)	
									12	B/O	-197		SOCKET HEAD CAP SCREW	S.S.	1/4-20 X 1/2 (MCMMASTER-CARR #92185A537)	
									12	B/O	-203		WASHER	S.S.	Ø3/8 (MCMMASTER-CARR #91950A031)	
									2	B/O	-205		WASHER	S.S.	Ø5/8 (MCMMASTER-CARR #91950A035)	
									6	B/O	-207		WASHER	S.S.	Ø1/2 (MCMMASTER-CARR #98017A210)	
		X									-209	1	PUCK ASSEMBLY			
X		1									-211		PUCK WELDMENT			
1											-213		PUCK RING	C.D.S. 1018		
3											-215		PUCK LEG	C.D.S. 1018		
3											-217		PUCK LEG END	1018		
		1									-219		PUCK ANCHOR	4140/4142 Q&T		
		3									-221		PUCK BRACKET	4140/4142		
		1								B/O	-223		SHACKLE		Ø1, 25,000 LB (MCMMASTER-CARR #8966T55)	
		1								B/O	-225		SLING HOOK		28,300 LB (MCMMASTER-CARR #3804T16)	
		3								B/O	-227		SOCKET HEAD CAP SCREW	S.S.	1/4-20 X 1-1/8 (MCMMASTER-CARR# 92196A543)	
									1	B/O	-229		BATTERY CHARGER		19-30V ULTRALIFE# CH0014	
			4							B/O	-231		SOCKET HEAD CAP SCREW	S.S.	#6-32 X 3/4 (MCMMASTER-CARR# 92196A151)	
			4							B/O	-233		WASHER	S.S.	#6 (MCMMASTER-CARR# 92141A008)	
			4							B/O	-235		NYLON INSERT HEX NUT	S.S.	#6-32 (MCMMASTER-CARR# 91831A007)	
									4	B/O	-237		THUMB SCREW	S.S.	1/4-20 X 1/2 (MCMMASTER-CARR# 91744A537)	
						1					-239		MANUAL RELEASE KNOB	6061		

This drawing, specifications, and concepts contained here in are the sole property of Dart Aerospace, and may not be reproduced or used in any fashion without the prior written permission of Dart Aerospace Eugene, OR.

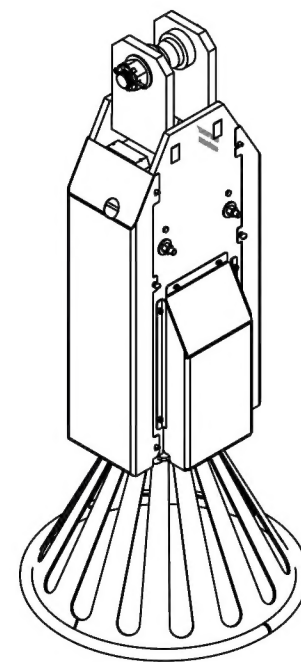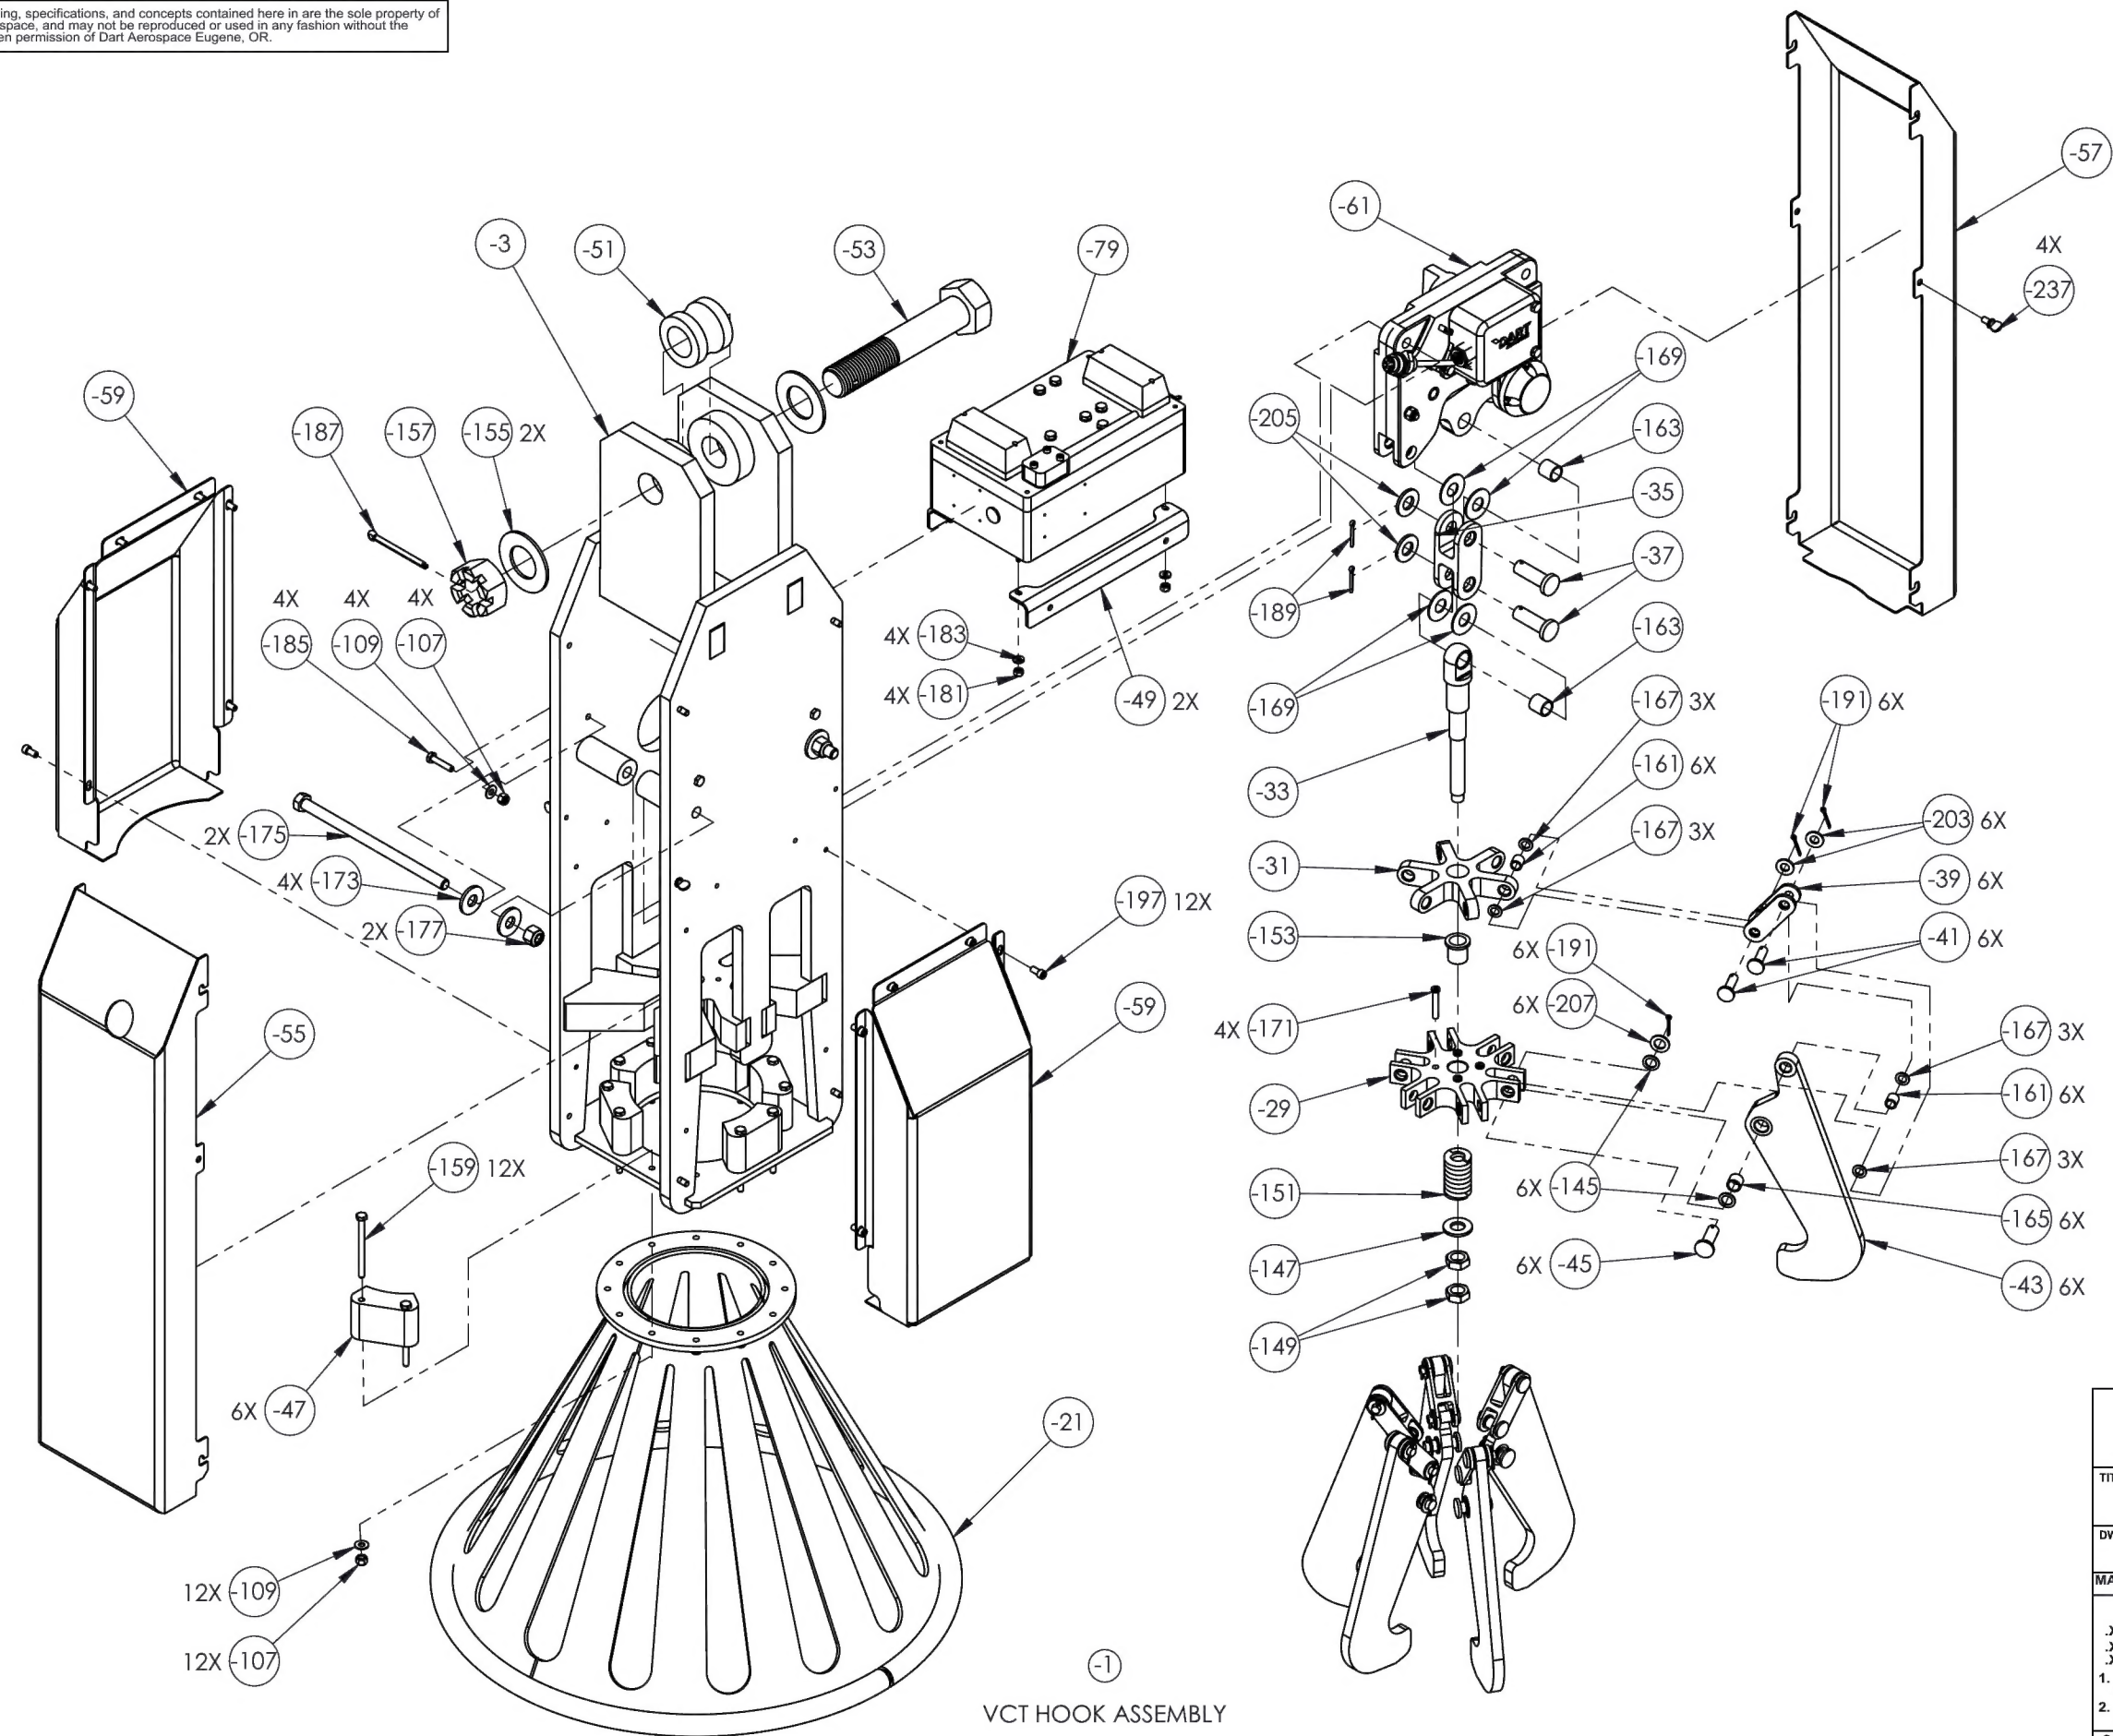

			
TITLE VERTICAL CAPTURE TRANSPORT			
DWG NO. VCT-3-1			REV 2
MAT'L		DRAWN BY: GILBERT	
UNLESS OTHERWISE SPECIFIED DIMENSIONS ARE IN INCHES .XXX ± .005 FRACTIONS ± 1/8 .XX ± .01 ANGLES ± 5° .X ± .1		APPROVED <i>J Gilbert</i>	
1. BREAK ALL SHARP EDGES .015 x .45" OR .015R		HEAT TREAT FINISH	
2. DIMENSIONAL LIMITS APPLY AFTER PLATING		SPEC	
SCALE 1:8		USED ON MODEL	
DATE	12/3/2014	SHEET 3 OF 57	

REVISIONS					
REV	ECR	DESCRIPTION	DATE	INITIAL	APPROVED
2	15-0149	3 ADDED NOTE 4.	6/22/2015	PMW	JAG

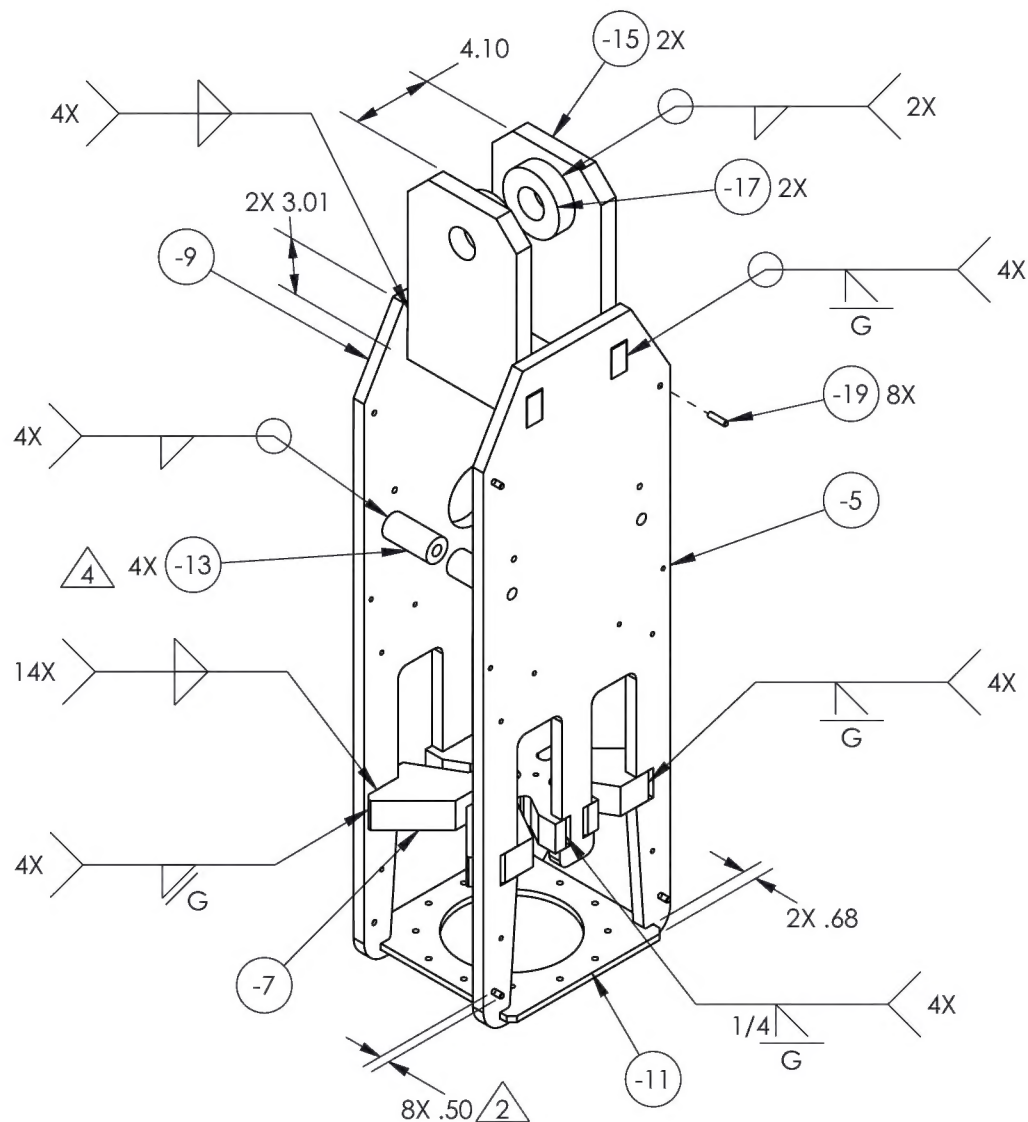

③
FRAME WELDMENT

NOTES:

1. MINIMUM FILLET WELD 1/4".
2. MASK PINS BEFORE POWDER COAT.
3. MASK HOLES BEFORE POWDER COAT.
4. ALIGN BOSSES -13 WITH HOOK SIDE PLATE -61.



TITLE VERTICAL CAPTURE TRANSPORT

DWG NO.	VCT-3-3
---------	---------

REV
2

MAT'L	DRAWN BY: DUERFELDT
-------	---------------------

APPROVED *J Gilbert*

DIMENSIONS ARE IN INCHES

.XXX	± .005	FRACTIONS ± 1/8
.XX	± .01	ANGLES ± 5°
X	± 1	

HEAT TREAT	7 900
FINISH	POWDER COAT

1. BREAK ALL SHARP EDGES .015 x 45° OR .015R
2. DIMENSIONAL LIMITS APPLY AFTER PLATING

5. SPEC	GLOSS WHITE
---------	-------------

USED ON MODEL


SCALE 1:8

DATE	12/3/2014
------	-----------



SHEET 4 OF 57

This drawing, specifications, and concepts contained here in are the sole property of Dart Aerospace, and may not be reproduced or used in any fashion without the prior written permission of Dart Aerospace Eugene, OR.

REVISIONS					
REV	ECR	DESCRIPTION	DATE	INITIAL	APPROVED
1	15-0005	REMOVED 2 HOLES USED WITH -59	1/6/2015	PW	JG
2	15-0149	-5 DELETED HOLES D1, D2, D3, D4. ADDED HOLES C7, C8.	6/24/2015	PMW	JAG

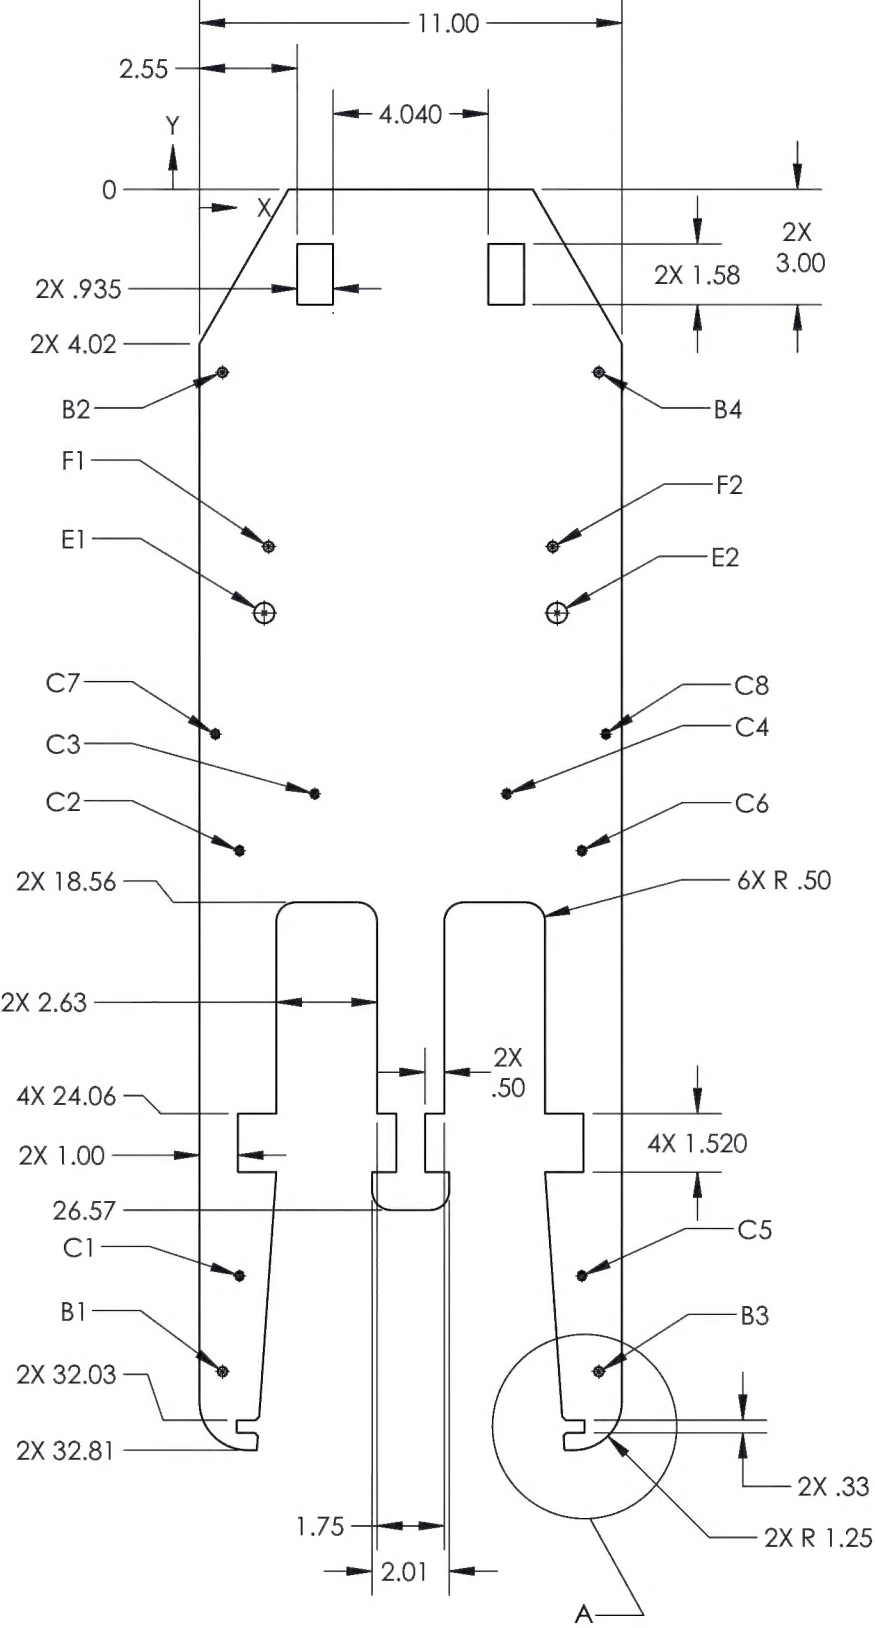



TAG	X LOC	Y LOC	SIZE
B1	.60	-30.77	ϕ .2496 THRU ϕ .2490
B2	.60	-4.76	
B3	10.40	-30.77	
B4	10.40	-4.76	
C1	1.04	-28.27	1/4-20 UNC - 2B THRU ALL
C2	1.04	-17.21	
C3	3.00	-15.73	
C4	8.00	-15.73	
C5	9.96	-28.27	
C6	9.96	-17.21	
C7	.42	-14.18	
C8	10.59	-14.18	
E1	1.69	-11.03	ϕ .53 THRU ALL
E2	9.31	-11.03	
F1	1.80	-9.30	ϕ .27 THRU ALL
F2	9.20	-9.30	

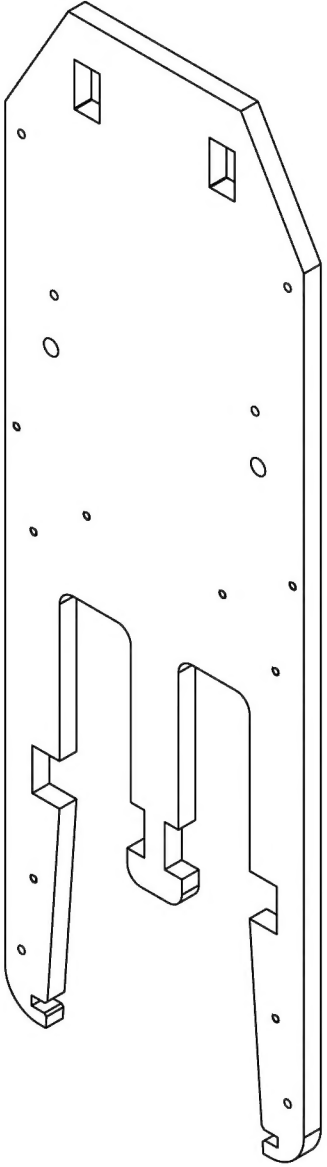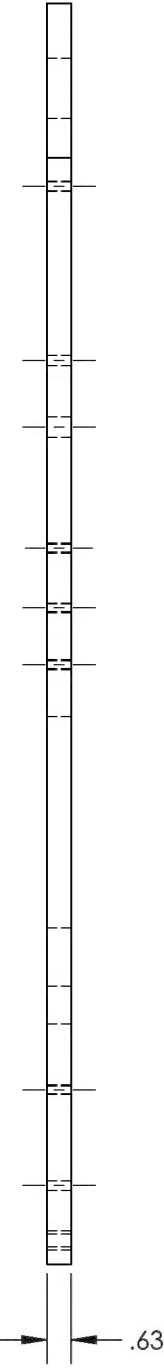

DART AEROSPACE			
TITLE VERTICAL CAPTURE TRANSPORT			
DWG NO. VCT-3-5			REV 2
MAT'L HR P&O		DRAWN BY: CLOUGH	
UNLESS OTHERWISE SPECIFIED DIMENSIONS ARE IN INCHES		APPROVED <i>J. Gilbert</i>	
.XXX \pm .005		TREAT	
.XX \pm .01		FINISH	
.X \pm .1		SEE -3 WELDMENT	
1. BREAK ALL SHARP EDGES .015 x 45° OR .015R		SPEC	
2. DIMENSIONAL LIMITS APPLY AFTER PLATING		USED ON MODEL	
SCALE	1:5	DATE	10/25/2013
		SHEET 5 OF 57	

This drawing, specifications, and concepts contained here in are the sole property of Dart Aerospace, and may not be reproduced or used in any fashion without the prior written permission of Dart Aerospace Eugene, OR.

REVISIONS					
REV	ECR	DESCRIPTION	DATE	INITIAL	APPROVED
1	15-0005	CHG MATERIAL TO 4140/4142	1/6/2015	PW	JG

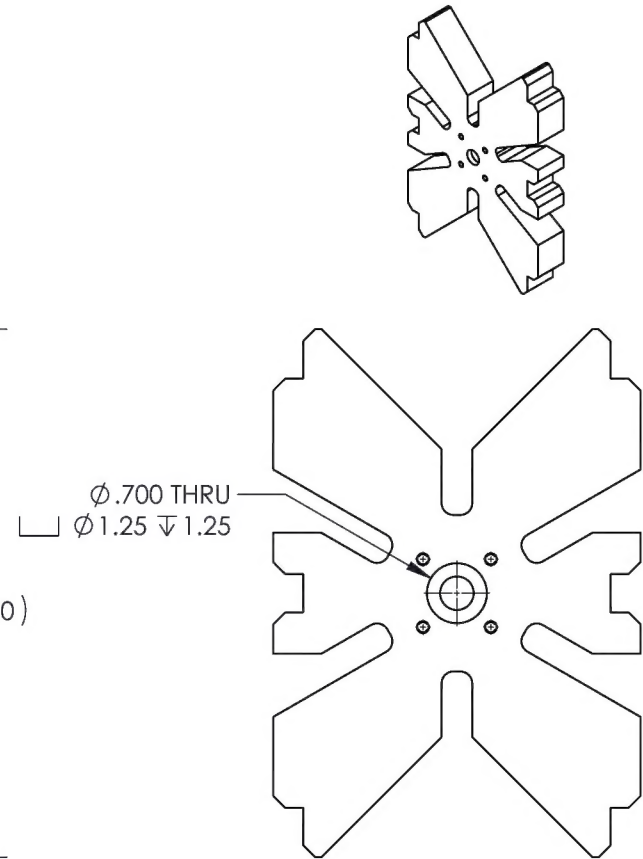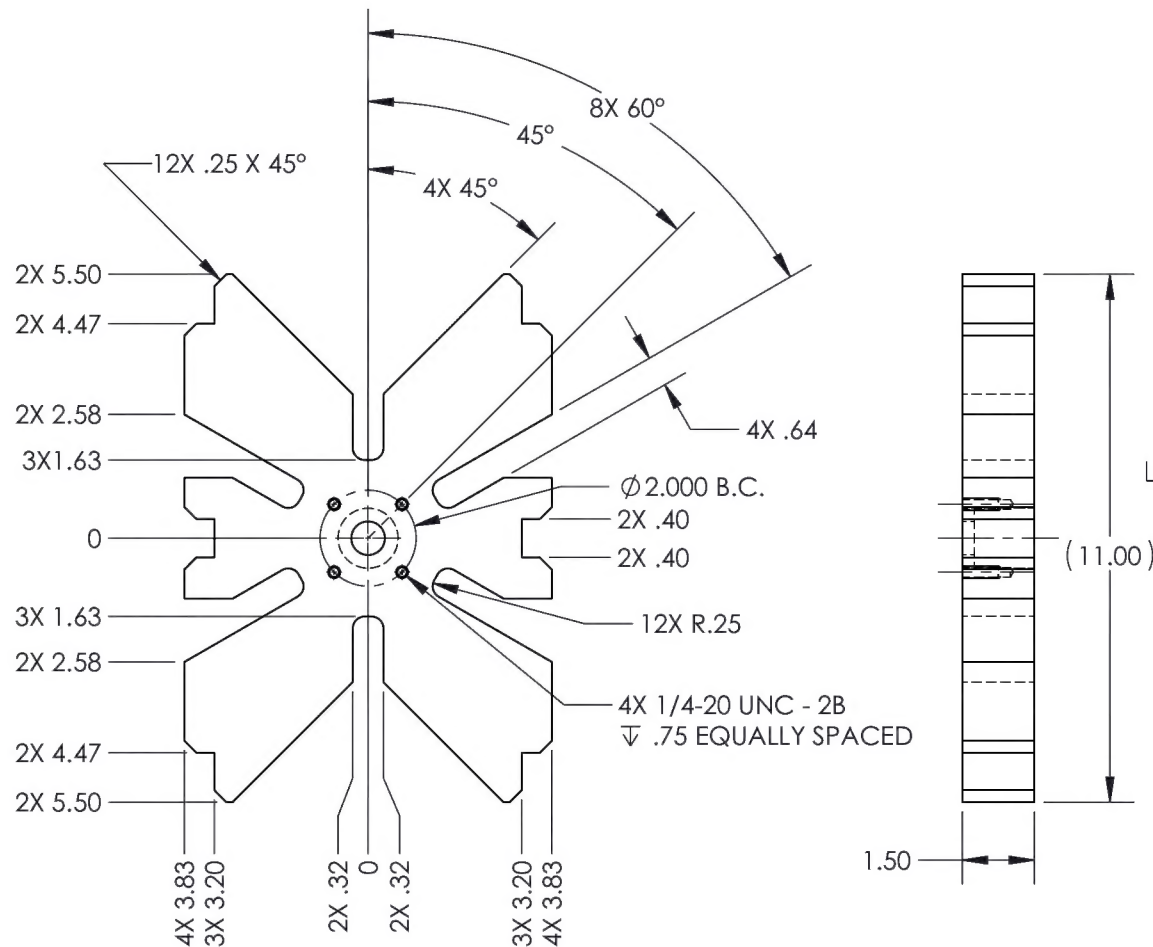


(-7)
PLATFORM

DART AEROSPACE	
TITLE VERTICAL CAPTURE TRANSPORT	
DWG NO. VCT-3-7	REV 2
MAT'L 4140/4142	DRAWN BY: CLOUGH
UNLESS OTHERWISE SPECIFIED DIMENSIONS ARE IN INCHES	APPROVED <i>J Gilbert</i>
.XXX ± .005 FRACTIONS ± 1/8	HEAT TREAT RC 19-23
.XX ± .01 ANGLES ± 5°	FINISH SEE -3 WELDMENT
.X ± .1	SPEC
1. BREAK ALL SHARP EDGES .015 x 45° OR .015R	USED ON MODEL
2. DIMENSIONAL LIMITS APPLY AFTER PLATING	
SCALE 1:4	DATE 12/3/2014
SHEET 6 OF 57	




This drawing, specifications, and concepts contained here in are the sole property of Dart Aerospace, and may not be reproduced or used in any fashion without the prior written permission of Dart Aerospace Eugene, OR.

REVISIONS					
REV	ECR	DESCRIPTION	DATE	INITIAL	APPROVED
1	15-0005	REMOVED 2 HOLES USED WITH -59	1/6/2015	PW	JG
2	15-0149	-9 DELETED HOLES E1, E2, E3, E4. ADDED HOLES D7, D8.	6/24/2015	PMW	JAG

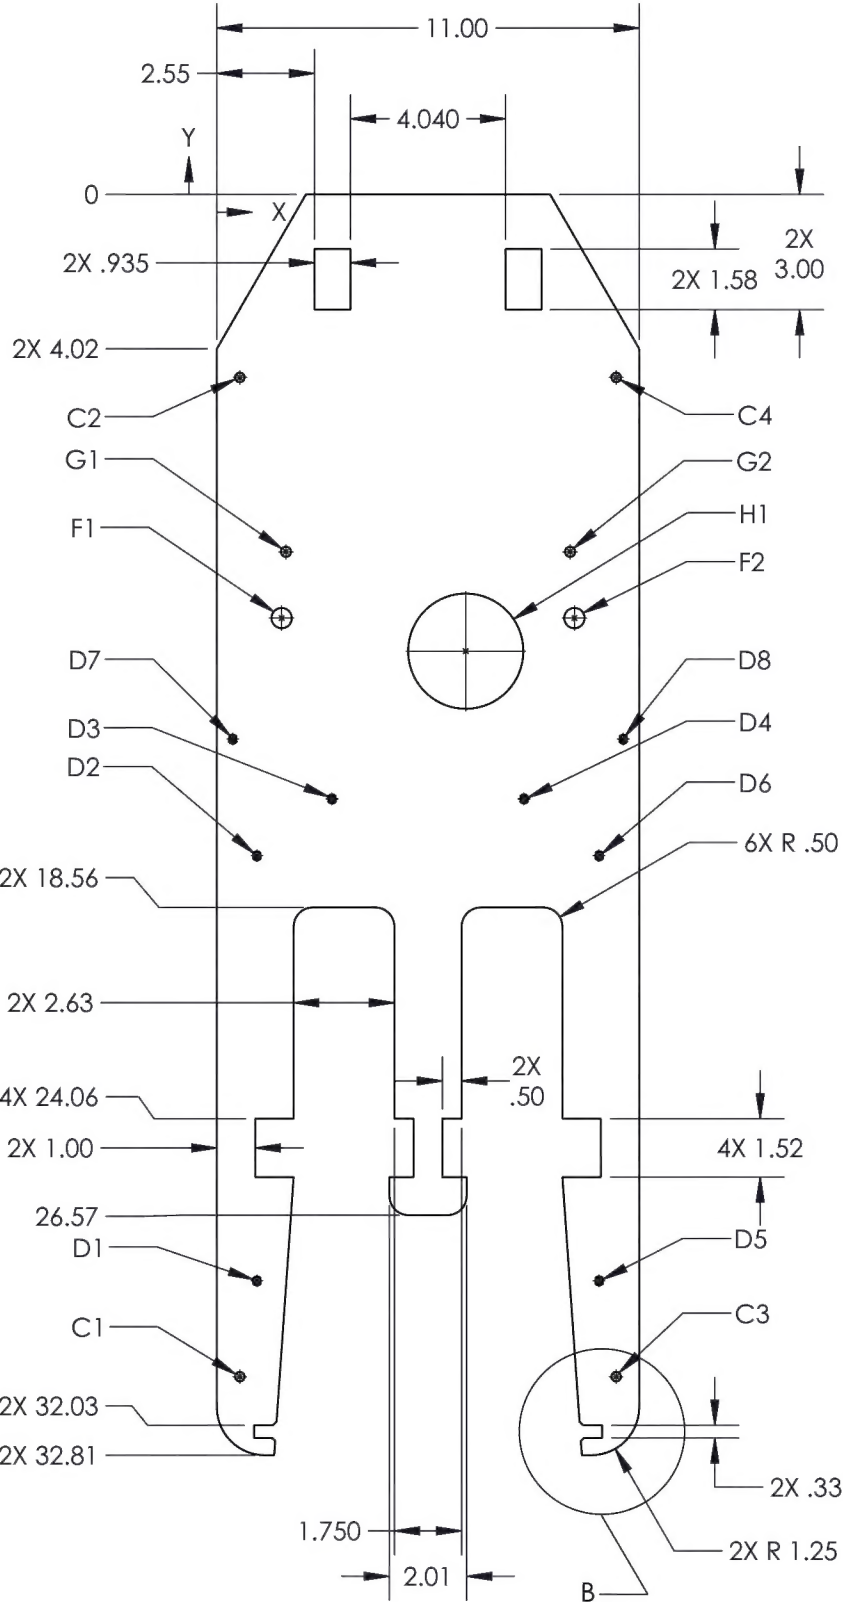

TAG	X LOC	Y LOC	SIZE
C1	.60	-30.77	ϕ .2496 THRU .2490
C2	.60	-4.76	
C3	10.40	-30.77	
C4	10.40	-4.76	
D1	1.04	-28.27	1/4-20 UNC - 2B THRU ALL
D2	1.04	-17.21	
D3	3.00	-15.73	
D4	8.00	-15.73	
D5	9.96	-28.27	
D6	9.96	-17.21	
D7	.42	-14.18	
D8	10.59	-14.18	
F1	1.69	-11.03	ϕ .53 THRU ALL
F2	9.31	-11.03	ϕ .27 THRU ALL
G1	1.80	-9.30	
G2	9.20	-9.30	ϕ 3.00 THRU
H1	6.48	-11.89	




OPEN HOLE FRAME

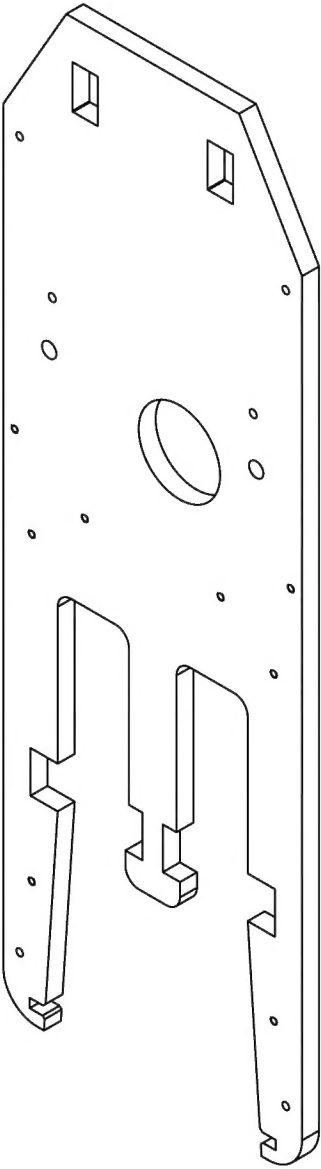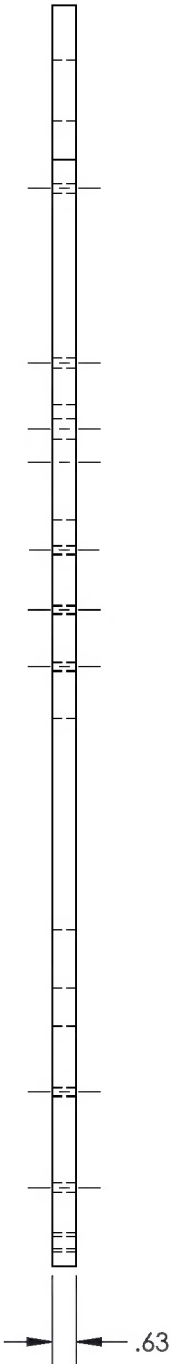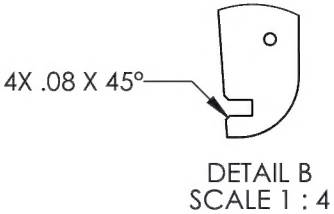

DART AEROSPACE			
TITLE VERTICAL CAPTURE TRANSPORT			
DWG NO. VCT-3-9			REV 2
MAT'L HR P&O		DRAWN BY: CLOUGH	
UNLESS OTHERWISE SPECIFIED DIMENSIONS ARE IN INCHES		APPROVED <i>J. Gilbert</i>	
.XXX ± .005		FRACTIONS ± 1/8	
.XX ± .01		ANGLES ± 5°	
.X ± .1		SEE -3 WELDMENT	
1. BREAK ALL SHARP EDGES .015 x 45° OR .015R		SPEC	
2. DIMENSIONAL LIMITS APPLY AFTER PLATING		USED ON MODEL	
SCALE 1:5	DATE 10/25/2013	SHEET 7 OF 57	

This drawing, specifications, and concepts contained here in are the sole property of Dart Aerospace, and may not be reproduced or used in any fashion without the prior written permission of Dart Aerospace Eugene, OR.

REVISIONS					
REV	ECR	DESCRIPTION	DATE	INITIAL	APPROVED

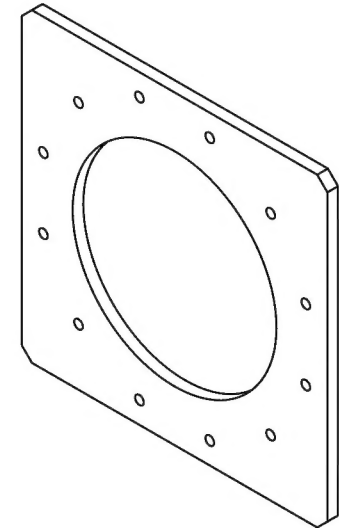
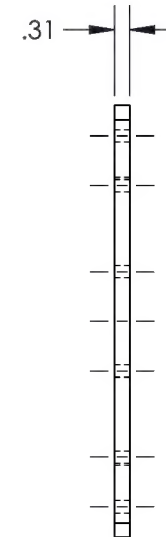
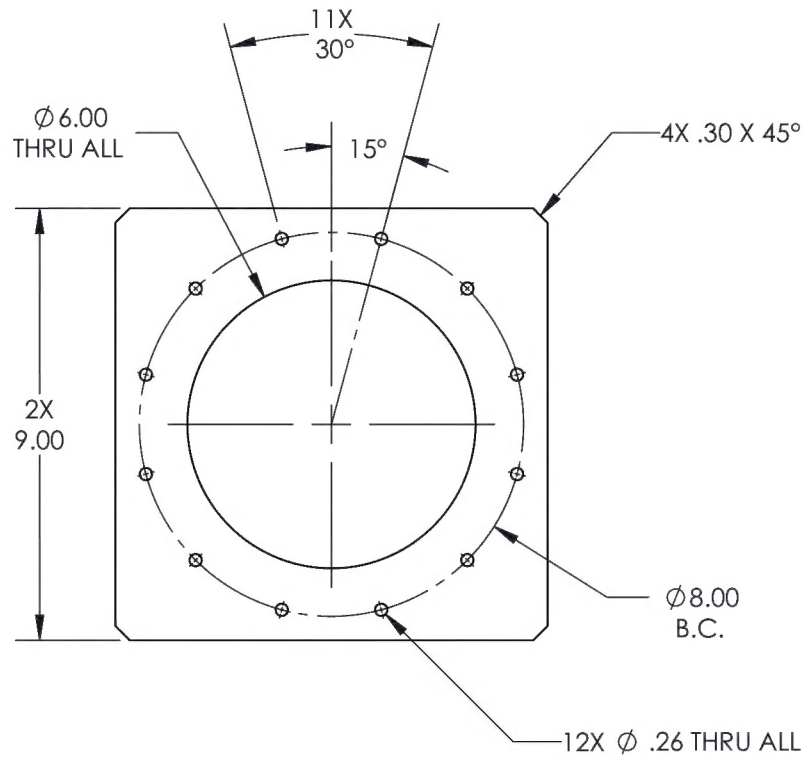


(-11)
FRAME FLANGE

DART AEROSPACE	
TITLE VERTICAL CAPTURE TRANSPORT	
DWG NO. VCT-3-11	REV 2
MAT'L HR P&O	DRAWN BY: DUERFELDT
UNLESS OTHERWISE SPECIFIED DIMENSIONS ARE IN INCHES	APPROVED <i>J Gilbert</i>
.XXX ± .005 FRACTIONS ± 1/8	HEAT TREAT
.XX ± .01 ANGLES ± 5°	FINISH SEE -3 WELDMENT
.X ± .1	SPEC
1. BREAK ALL SHARP EDGES .015 x 45° OR .015R	USED ON MODEL
2. DIMENSIONAL LIMITS APPLY AFTER PLATING	
SCALE 1:4	DATE 12/2/2014 SHEET 8 OF 57

This drawing, specifications, and concepts contained here in are the sole property of Dart Aerospace, and may not be reproduced or used in any fashion without the prior written permission of Dart Aerospace Eugene, OR.

REVISIONS				
REV	ECR	DESCRIPTION	DATE	INITIAL
				APPROVED

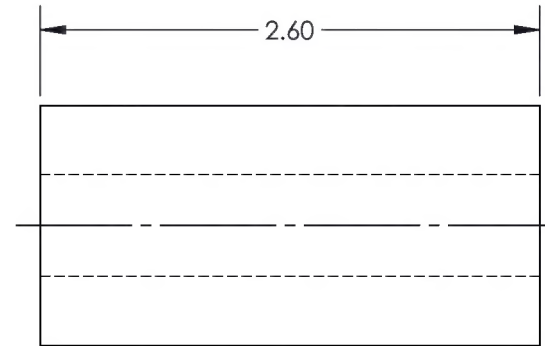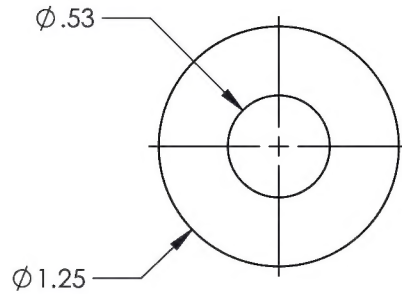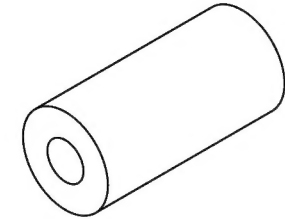




(-13)

BOSS, HOOK

DART AEROSPACE	
TITLE VERTICAL CAPTURE TRANSPORT	
DWG NO. VCT-3-13	REV 2
MAT'L A36	DRAWN BY: DUERFELDT
UNLESS OTHERWISE SPECIFIED DIMENSIONS ARE IN INCHES	APPROVED <i>J Gilbert</i>
.XXX ± .005	HEAT TREAT
.XX ± .01	FINISH SEE -3 WELDMENT
.X ± .1	ANGLES ± 5°
1. BREAK ALL SHARP EDGES .015 x 45° OR .015R	SPEC
2. DIMENSIONAL LIMITS APPLY AFTER PLATING	USED ON MODEL
SCALE 1:1	DATE 12/2/2014
SHEET 9 OF 57	

This drawing, specifications, and concepts contained here in are the sole property of Dart Aerospace, and may not be reproduced or used in any fashion without the prior written permission of Dart Aerospace Eugene, OR.

REVISIONS					
REV	ECR	DESCRIPTION	DATE	INITIAL	APPROVED
1	15-0005	INCREASED WIDTH BY .06 TO 6.40	1/6/2015	PW	JG

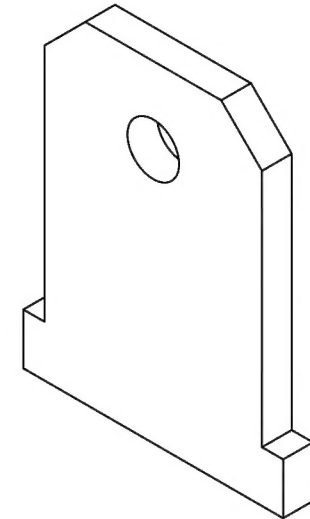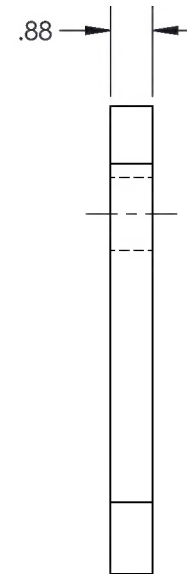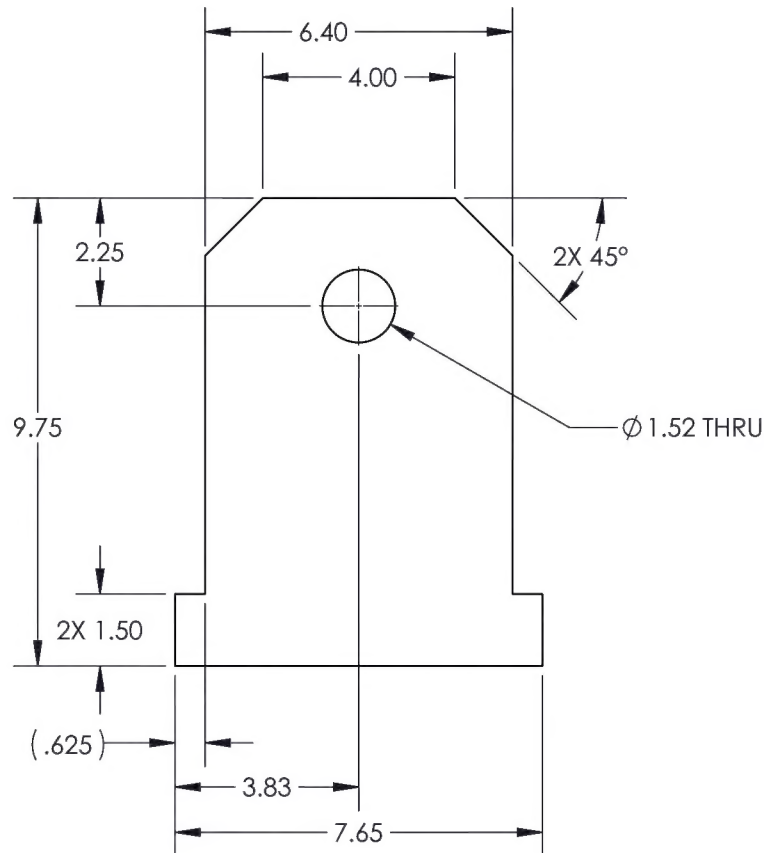




(-15)

LIFTING PLATE

DART AEROSPACE	
TITLE VERTICAL CAPTURE TRANSPORT	
DWG NO. VCT-3-15	REV 2
MAT'L HR P&O	DRAWN BY: DUERFELDT
UNLESS OTHERWISE SPECIFIED DIMENSIONS ARE IN INCHES	APPROVED <i>J Gilbert</i>
.XXX ± .005	HEAT TREAT
.XX ± .01	FINISH SEE -3 WELDMENT
.X ± .1	ANGLES ± 5°
1. BREAK ALL SHARP EDGES .015 x 45° OR .015R	SPEC
2. DIMENSIONAL LIMITS APPLY AFTER PLATING	USED ON MODEL
SCALE 1:4	DATE 12/3/2014
SHEET 10 OF 57	

This drawing, specifications, and concepts contained here in are the sole property of Dart Aerospace, and may not be reproduced or used in any fashion without the prior written permission of Dart Aerospace Eugene, OR.

REVISIONS				
REV	ECR	DESCRIPTION	DATE	INITIAL
				APPROVED

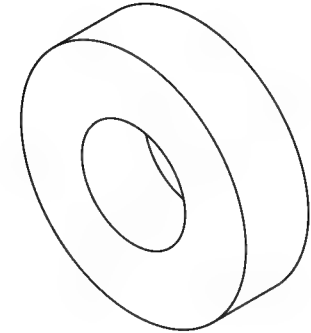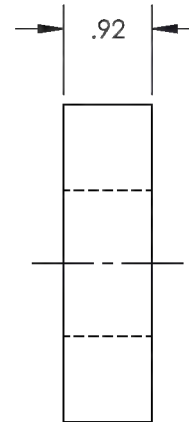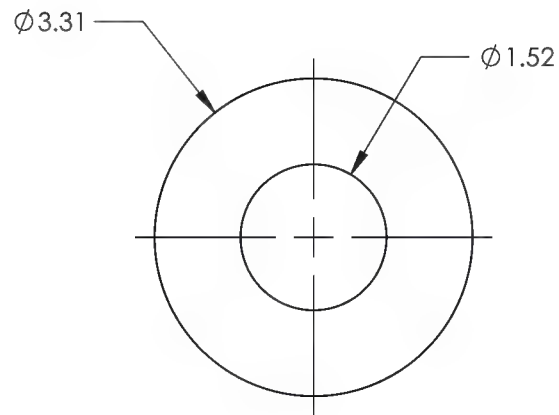



(-17)

LIFTING BOSS

DART AEROSPACE	
TITLE VERTICAL CAPTURE TRANSPORT	
DWG NO. VCT-3-17	REV 2
MAT'L A36	DRAWN BY: DUERFELDT
UNLESS OTHERWISE SPECIFIED DIMENSIONS ARE IN INCHES	APPROVED <i>J Gilbert</i>
.XXX $\pm .005$	HEAT TREAT
.XX $\pm .01$	FINISH SEE -3 WELDMENT
.X $\pm .1$	SPEC
1. BREAK ALL SHARP EDGES .015 x 45° OR .015R	USED ON MODEL
2. DIMENSIONAL LIMITS APPLY AFTER PLATING	
SCALE 1:2	DATE 12/3/2014
SHEET 11 OF 57	

This drawing, specifications, and concepts contained here in are the sole property of Dart Aerospace, and may not be reproduced or used in any fashion without the prior written permission of Dart Aerospace Eugene, OR.

REVISIONS							
REV	ECR	DESCRIPTION			DATE	INITIAL	APPROVED

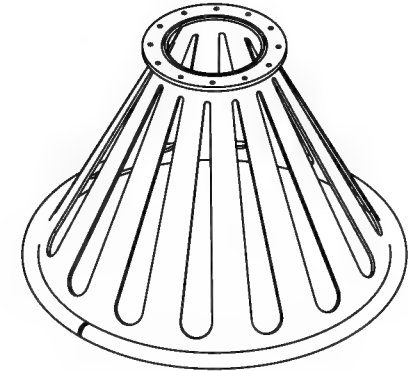
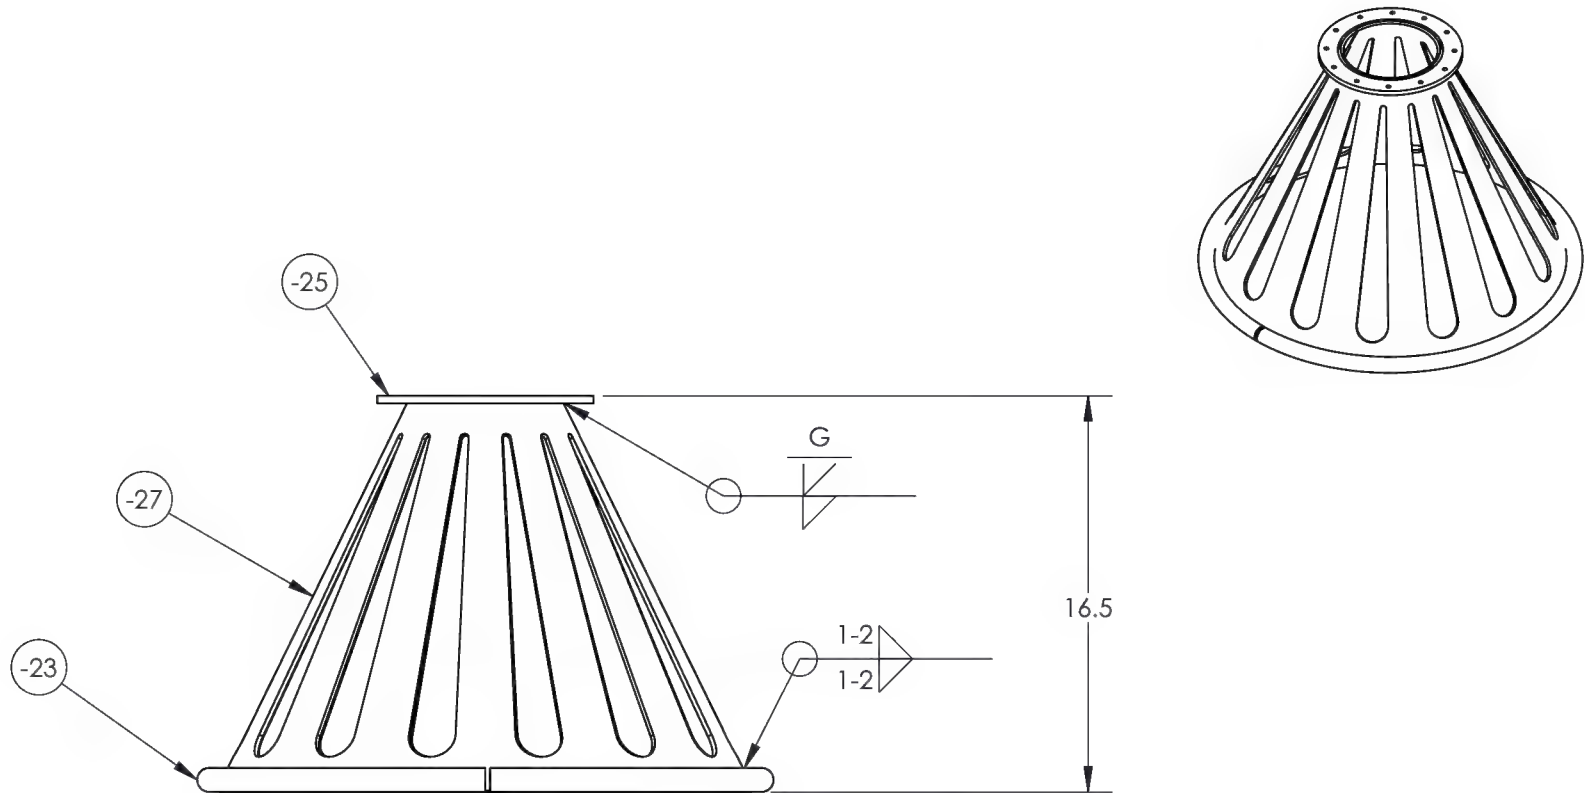


(-21)
CONE WELDMENT

DART AEROSPACE	
TITLE VERTICAL CAPTURE TRANSPORT	
DWG NO. VCT-3-21	REV 2
MAT'L UNLESS OTHERWISE SPECIFIED DIMENSIONS ARE IN INCHES .XXX ± .005 FRACTIONS ± 1/8 .XX ± .01 ANGLES ± 5° .X ± .1	DRAWN BY: GILBERT APPROVED: <i>J Gilbert</i> HEAT TREAT FINISH POWDER COAT SPEC GLOSS WHITE USED ON MODEL
1. BREAK ALL SHARP EDGES .015 x 45° OR .015R 2. DIMENSIONAL LIMITS APPLY AFTER PLATING	
SCALE 1:8	DATE 10/25/2013
SHEET 12 OF 57	

This drawing, specifications, and concepts contained here in are the sole property of Dart Aerospace, and may not be reproduced or used in any fashion without the prior written permission of Dart Aerospace Eugene, OR.

REVISIONS			
REV	ECR	DESCRIPTION	DATE
			INITIAL
			APPROVED


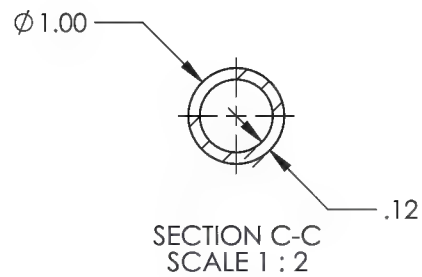
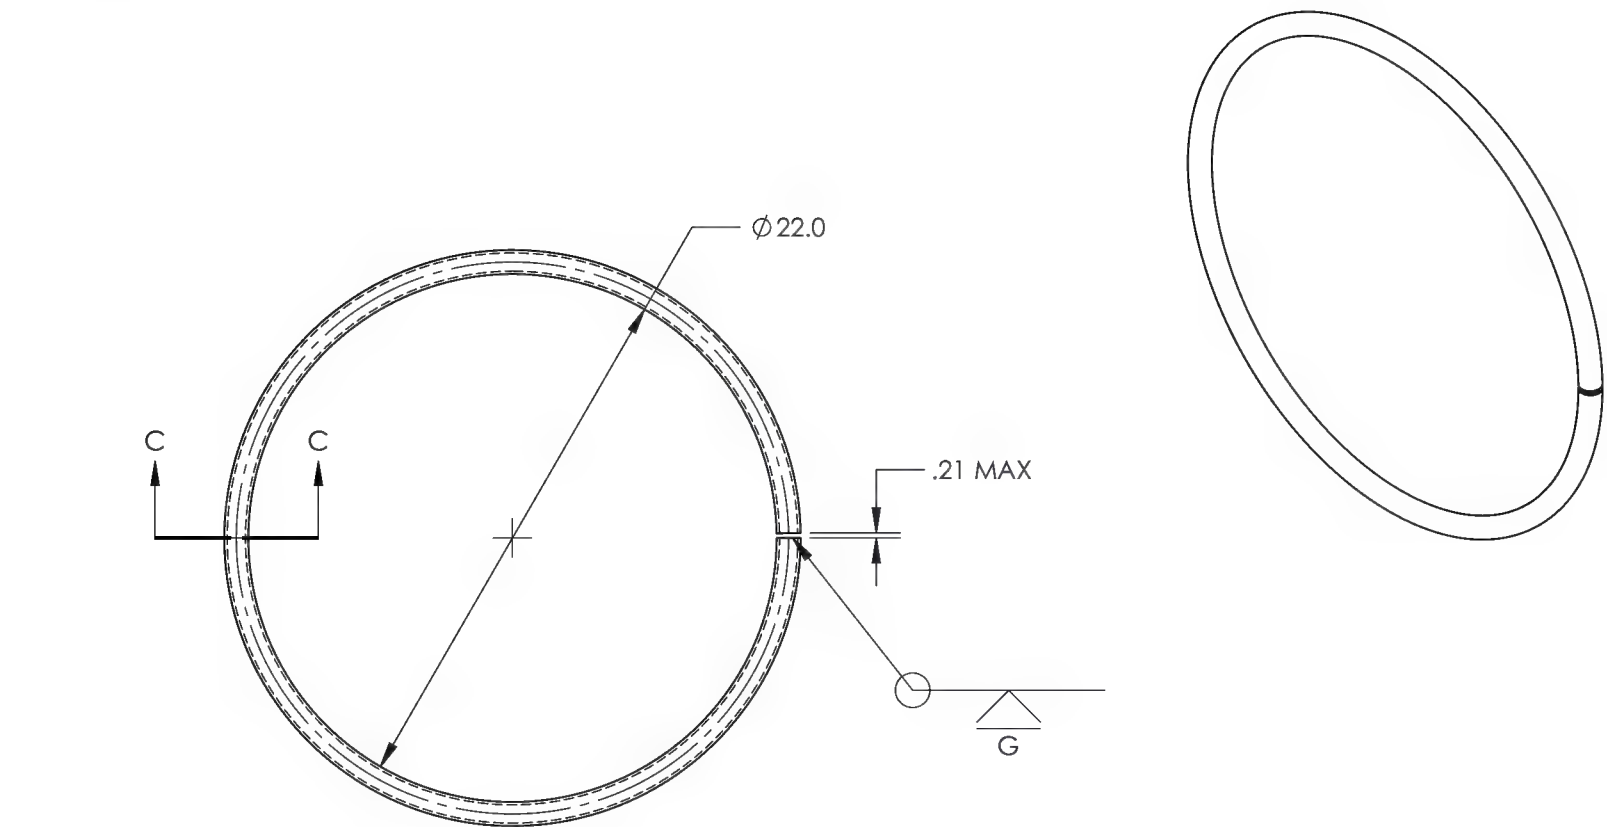


(-23)
CONE RING

DART AEROSPACE	
TITLE VERTICAL CAPTURE TRANSPORT	
DWG NO. VCT-3-23	REV 2
MAT'L C.D.S. 1018	DRAWN BY: GILBERT
UNLESS OTHERWISE SPECIFIED DIMENSIONS ARE IN INCHES	APPROVED <i>J Gilbert</i>
.XXX ± .005 FRACTIONS ± 1/8	HEAT TREAT
.XX ± .01 ANGLES ± 5°	FINISH SEE WELDMENT -39
.X ± .1	SPEC
1. BREAK ALL SHARP EDGES .015 x 45° OR .015R	USED ON MODEL
2. DIMENSIONAL LIMITS APPLY AFTER PLATING	
SCALE 1:8	DATE 10/25/2013
SHEET 13 OF 57	

This drawing, specifications, and concepts contained here in are the sole property of Dart Aerospace, and may not be reproduced or used in any fashion without the prior written permission of Dart Aerospace Eugene, OR.

REVISIONS				
REV	ECR	DESCRIPTION	DATE	INITIAL

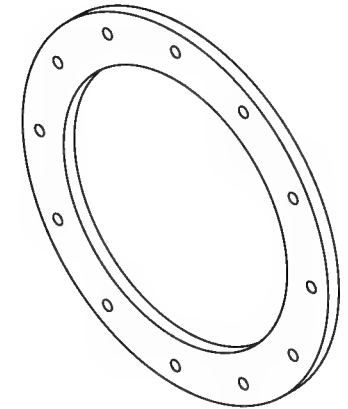
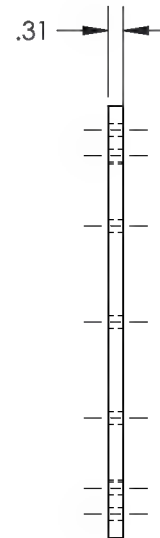
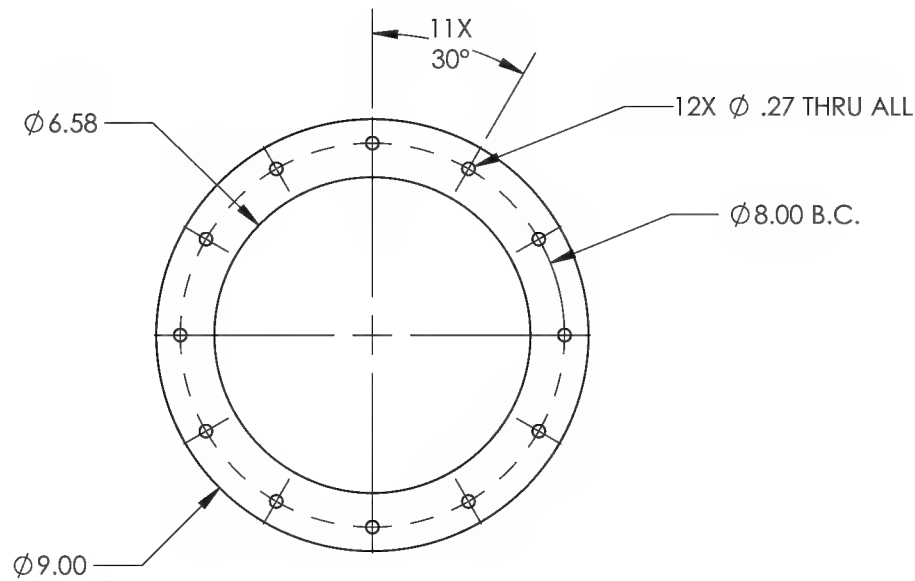


(-25)
CONE FLANGE

DART AEROSPACE	
TITLE VERTICAL CAPTURE TRANSPORT	
DWG NO. VCT-3-25	REV 2
MAT'L A36	DRAWN BY: GILBERT
UNLESS OTHERWISE SPECIFIED DIMENSIONS ARE IN INCHES	APPROVED <i>J Gilbert</i>
.XXX ± .005	HEAT TREAT
.XX ± .01	FINISH SEE WELDMENT -39
.X ± .1	ANGLES ± 5°
1. BREAK ALL SHARP EDGES .015 x 45° OR .015R	SPEC
2. DIMENSIONAL LIMITS APPLY AFTER PLATING	USED ON MODEL
SCALE 1:4	DATE 10/25/2013
SHEET 14 OF 57	

This drawing, specifications, and concepts contained here in are the sole property of Dart Aerospace, and may not be reproduced or used in any fashion without the prior written permission of Dart Aerospace Eugene, OR.

REVISIONS				
REV	ECR	DESCRIPTION	DATE	INITIAL

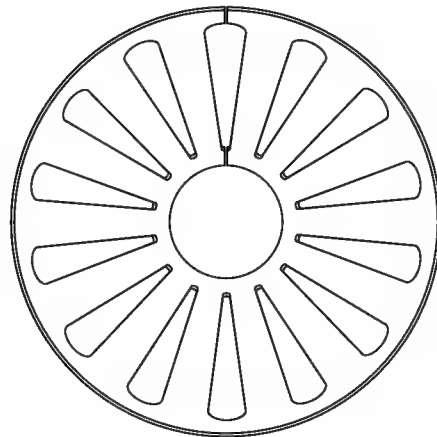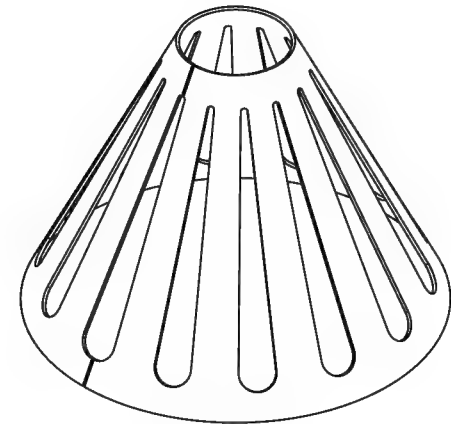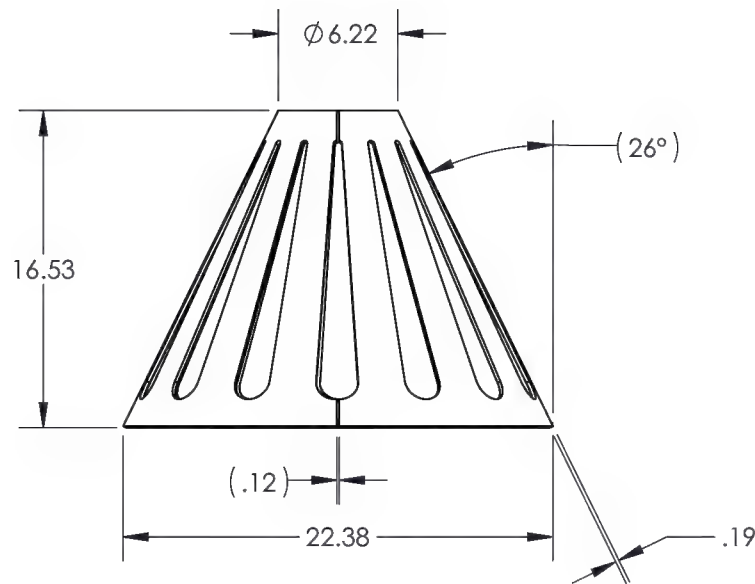

(-27)



CONE

NOTE:
VENDOR OPTION: 2 SEAMS OK.

DART AEROSPACE	
TITLE VERTICAL CAPTURE TRANSPORT	
DWG NO. VCT-3-27	REV 2
MAT'L HR PLATE	DRAWN BY: GILBERT
UNLESS OTHERWISE SPECIFIED DIMENSIONS ARE IN INCHES	APPROVED <i>J Gilbert</i>
.XXX \pm .005	HEAT
.XX \pm .01	TREAT
.X \pm .1	FINISH SEE WELDMENT -39
1. BREAK ALL SHARP EDGES .015 x 45° OR .015R	SPEC
2. DIMENSIONAL LIMITS APPLY AFTER PLATING	USED ON MODEL
SCALE 1:10	DATE 10/25/2013
SHEET 15 OF 57	

This drawing, specifications, and concepts contained here in are the sole property of Dart Aerospace, and may not be reproduced or used in any fashion without the prior written permission of Dart Aerospace Eugene, OR.

REVISIONS						
REV	ECR	DESCRIPTION	DATE	INITIAL	APPROVED	

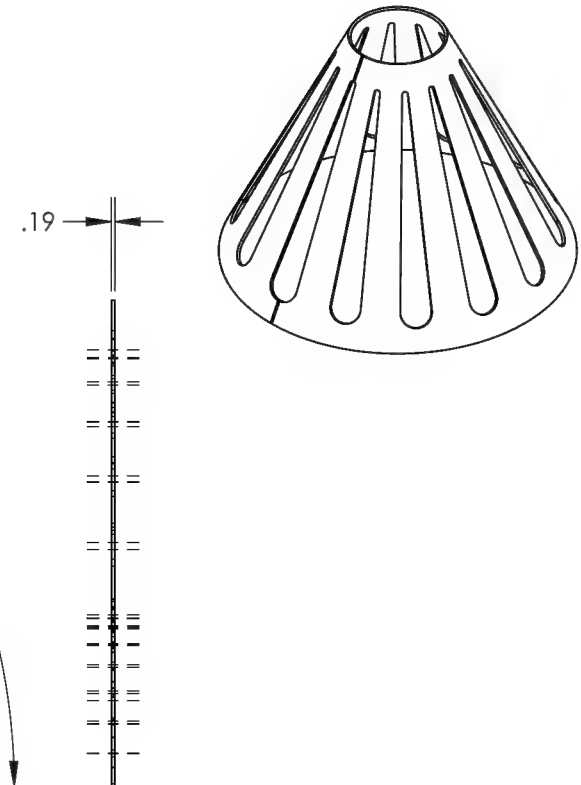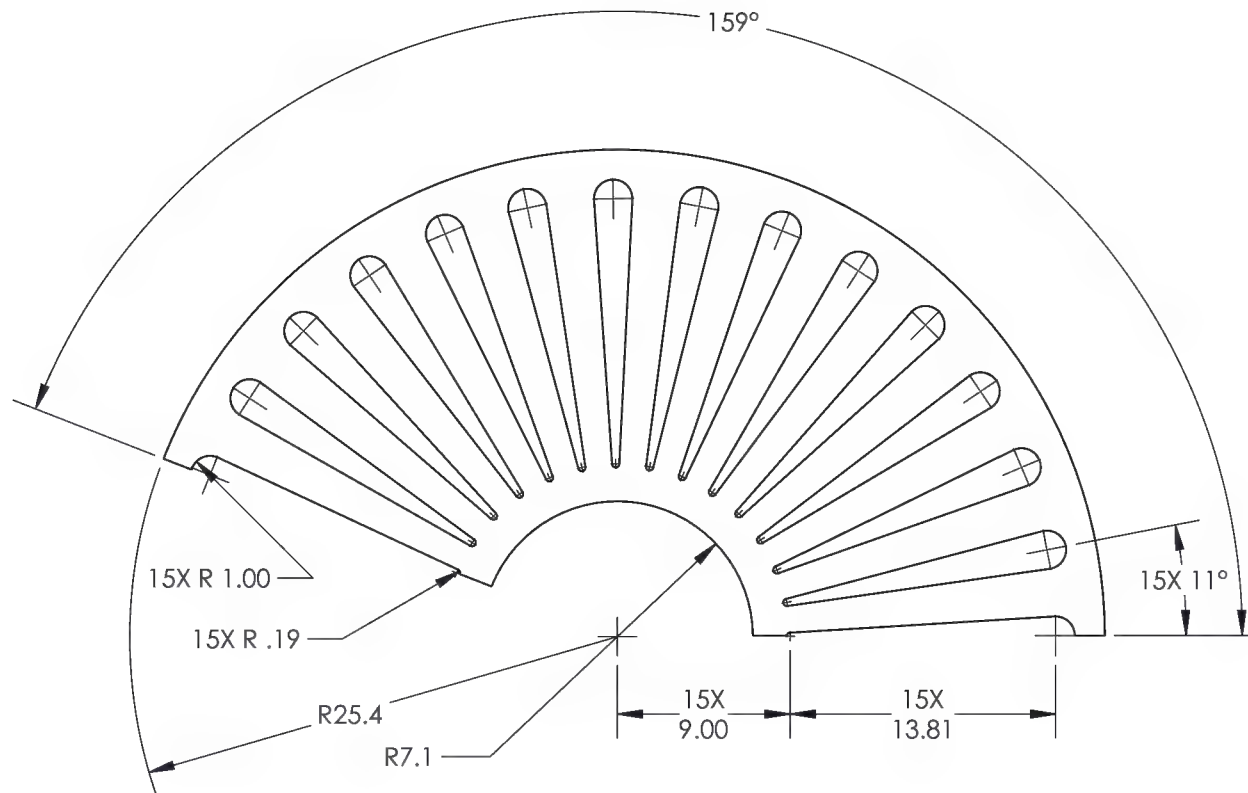

NOTE:
VENDOR OPTION: 2 SEAMS OK.

DIMENSIONS FOR REFERENCE ONLY





-27A

CONE FLAT PATTERN

DART AEROSPACE	
TITLE VERTICAL CAPTURE TRANSPORT	
DWG NO. VCT-3-27A	REV 2
MAT'L HR PLATE	DRAWN BY: GILBERT
UNLESS OTHERWISE SPECIFIED DIMENSIONS ARE IN INCHES	APPROVED <i>J Gilbert</i>
.XXX ± .005 FRACTIONS ± 1/8	HEAT TREAT
.XX ± .01 ANGLES ± 5°	FINISH SEE WELDMENT -39
.X ± .1	SPEC
1. BREAK ALL SHARP EDGES .015 x 45° OR .015R	USED ON MODEL
2. DIMENSIONAL LIMITS APPLY AFTER PLATING	
SCALE 1:10	DATE 10/25/2013
SHEET 16 OF 57	

This drawing, specifications, and concepts contained here in are the sole property of Dart Aerospace, and may not be reproduced or used in any fashion without the prior written permission of Dart Aerospace Eugene, OR.

REVISIONS				
REV	ECR	DESCRIPTION	DATE	INITIAL
2	15-0149	-29 CH'D BORE DIA WAS LIMITS Ø.7518-7513 IS LIMITS Ø.8768-.8763. REMOVED COUNTERSINKS.	6/22/2015	PMW
				APPROVED JAG

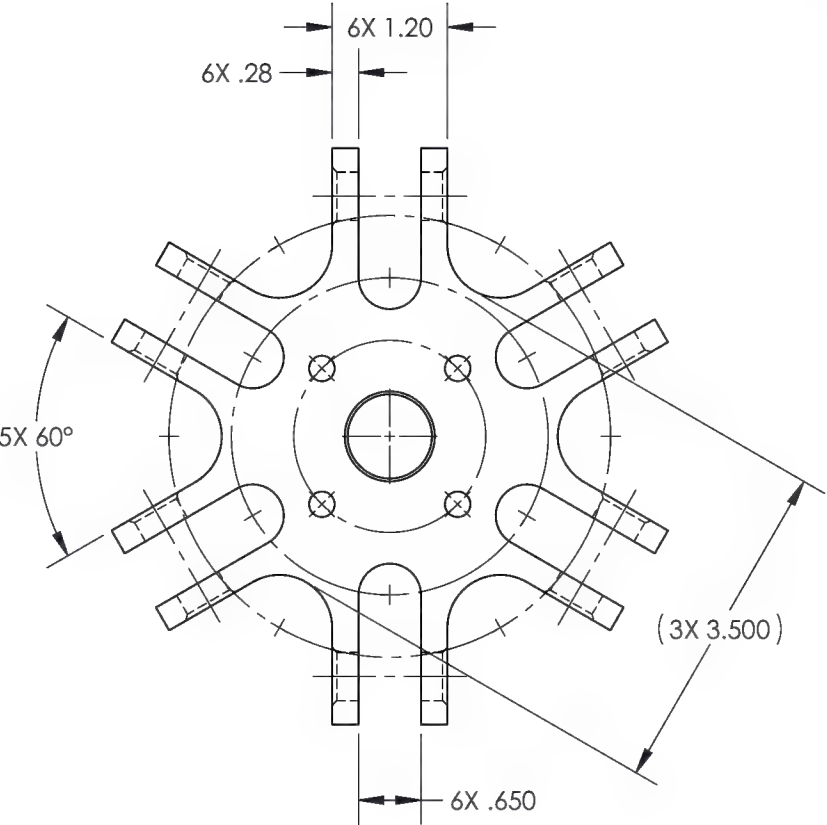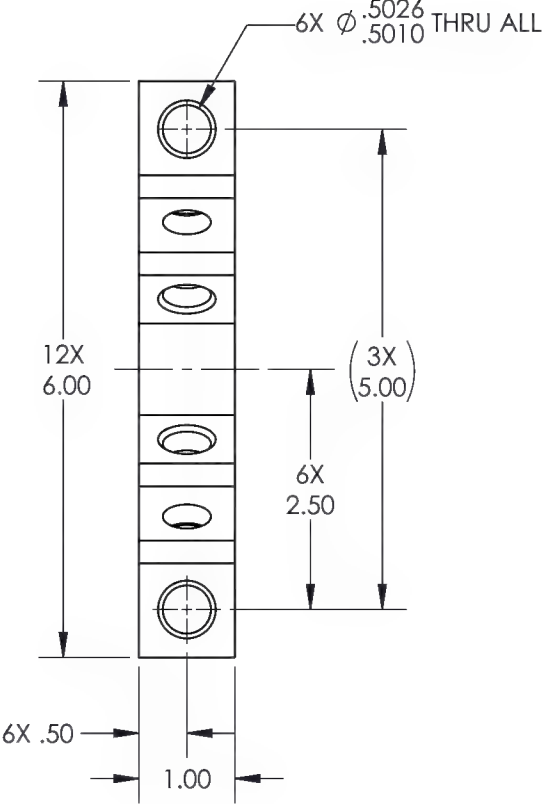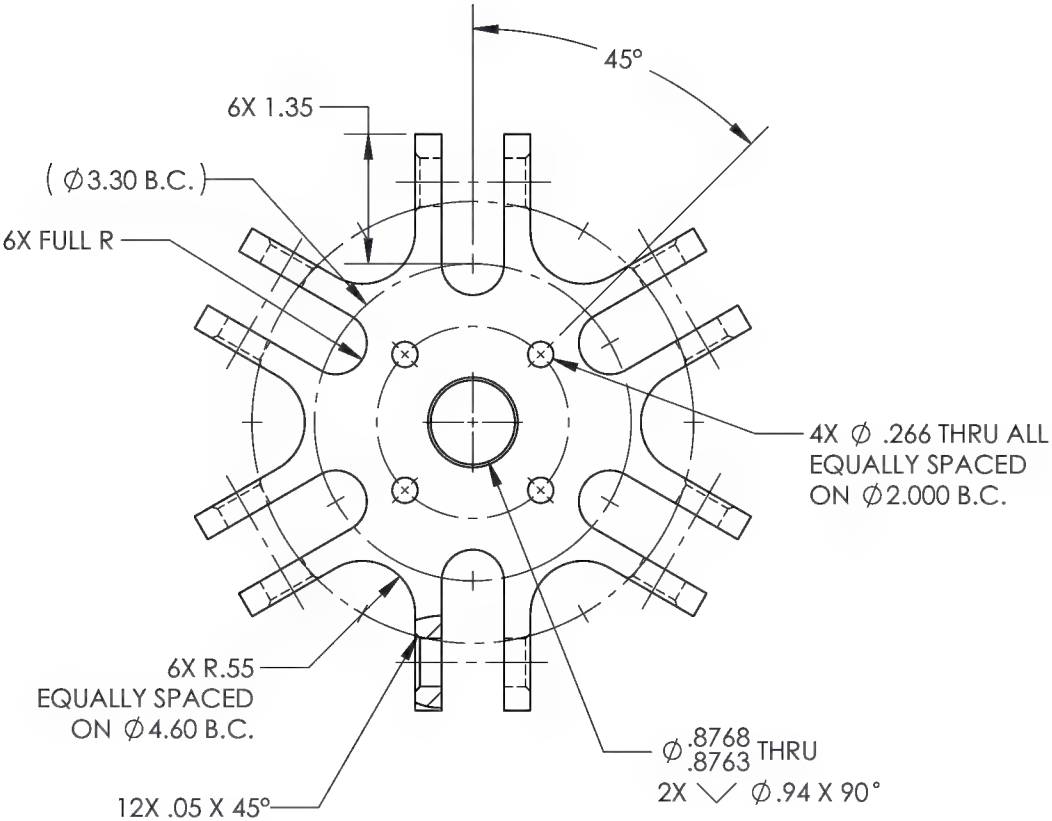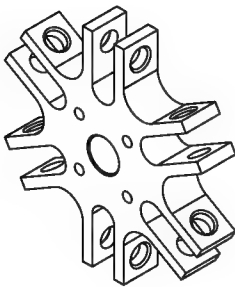

-29



MAIN RING

NOTE:
1. NICKEL PLATE .0004 - .0006, BAKE AFTER PLATING.

DART AEROSPACE		
DWG NO. VCT-3-29		REV 2
MAT'L 4140/4142		DRAWN BY: CLOUGH
UNLESS OTHERWISE SPECIFIED DIMENSIONS ARE IN INCHES		APPROVED <i>J. Gilbert</i>
.XXX ± .005 FRACTIONS ± 1/8		HEAT TREAT RC 35-39
.XX ± .01 ANGLES ± 5°		FINISH SEE NOTE 1
.X ± .1		SPEC
1. BREAK ALL SHARP EDGES .015 x 45° OR .015R		USED ON MODEL
2. DIMENSIONAL LIMITS APPLY AFTER PLATING		
SCALE 1:2	DATE 12/2/2014	SHEET 17 OF 57


This drawing, specifications, and concepts contained here in are the sole property of Dart Aerospace, and may not be reproduced or used in any fashion without the prior written permission of Dart Aerospace Eugene, OR.

REVISIONS				
REV	ECR	DESCRIPTION	DATE	INITIAL

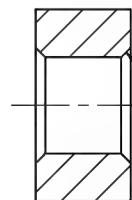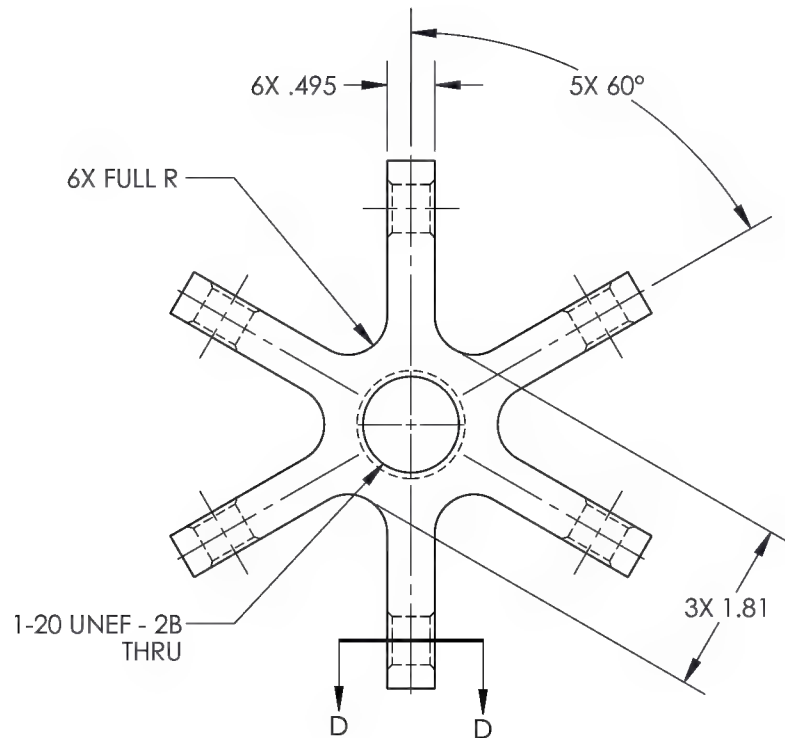

SECTION D-D
SCALE 1 : 1

(-31)
CROSS



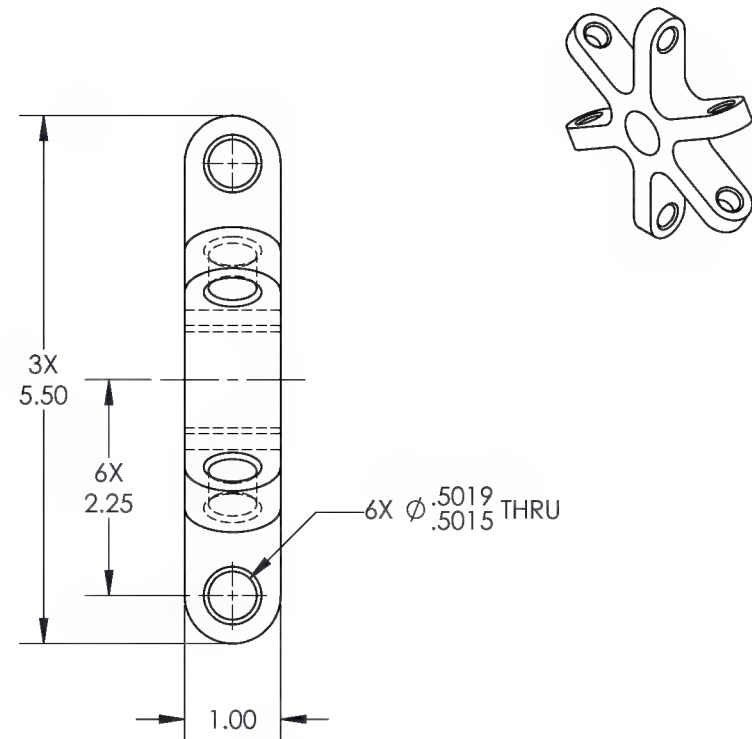


NOTE:
1. NICKEL PLATE .0004 - .0006, BAKE AFTER PLATING.

DART AEROSPACE	
TITLE VERTICAL CAPTURE TRANSPORT	
DWG NO. VCT-3-31	REV 2
MAT'L 4140/4142	DRAWN BY: CLOUGH
UNLESS OTHERWISE SPECIFIED DIMENSIONS ARE IN INCHES	APPROVED <i>J. Gilbert</i>
.XXX ± .005 FRACTIONS ± 1/8	HEAT TREAT RC 35-39
.XX ± .01 ANGLES ± 5°	FINISH SEE NOTE 1
.X ± .1	SPEC
1. BREAK ALL SHARP EDGES .015 x 45° OR .015R	USED ON MODEL
2. DIMENSIONAL LIMITS APPLY AFTER PLATING	
SCALE 1:2	DATE 12/2/2014
SHEET 18 OF 57	

This drawing, specifications, and concepts contained here in are the sole property of Dart Aerospace, and may not be reproduced or used in any fashion without the prior written permission of Dart Aerospace Eugene, OR.

REVISIONS					
REV	ECR	DESCRIPTION	DATE	INITIAL	APPROVED
2	15-0149	-33 CH'D ROD DIA WAS LIMITS Ø.6240-.6230 IS LIMITS Ø.7495-.7483.	6/22/2015	PMW	JAG

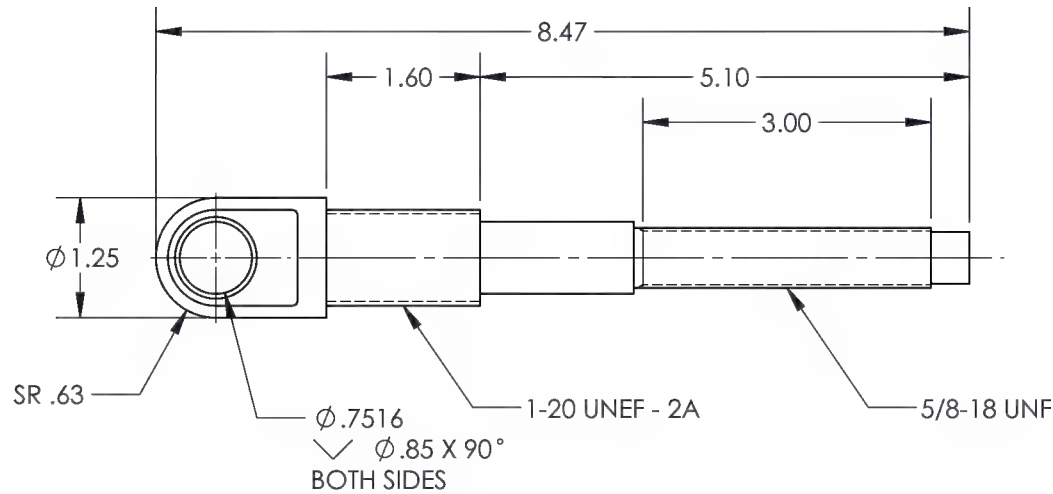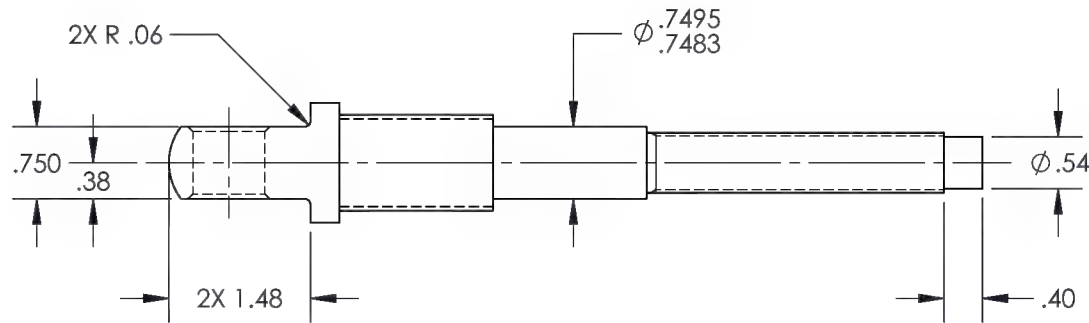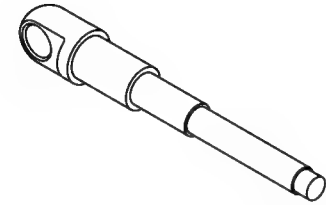

NOTE:
1. NICKEL PLATE .0004 - .0006, BAKE AFTER PLATING.





DART AEROSPACE	
TITLE VERTICAL CAPTURE TRANSPORT	
DWG NO. VCT-3-33	REV 2
MAT'L 4140/4142 Q&T	DRAWN BY: CLOUGH
UNLESS OTHERWISE SPECIFIED DIMENSIONS ARE IN INCHES	APPROVED <i>J Gilbert</i>
.XXX ± .005	HEAT TREAT
.XX ± .01	FINISH SEE NOTE 1
.X ± .1	ANGLES ± 5°
1. BREAK ALL SHARP EDGES .015 x 45° OR .015R	SPEC
2. DIMENSIONAL LIMITS APPLY AFTER PLATING	USED ON MODEL
SCALE 1:2	DATE 12/2/2014
SHEET 19 OF 57	

(-33)

PUSH ROD

This drawing, specifications, and concepts contained here in are the sole property of Dart Aerospace, and may not be reproduced or used in any fashion without the prior written permission of Dart Aerospace Eugene, OR.

REVISIONS				
REV	ECR	DESCRIPTION	DATE	INITIAL
				APPROVED

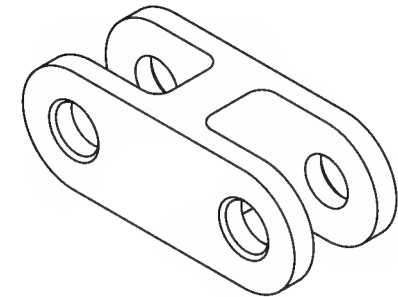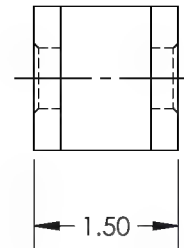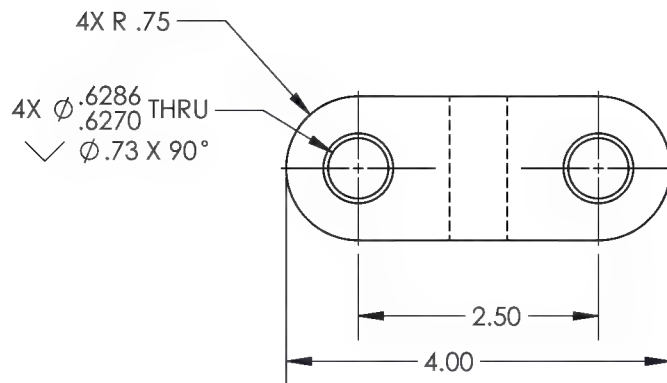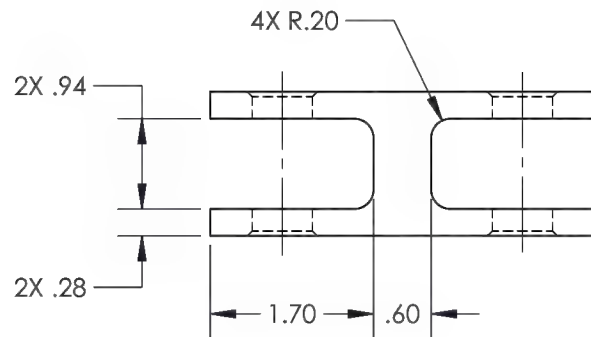

NOTE:

1. NICKEL PLATE .0004-.0006, BAKE AFTER PLATING.




(-35)

PUSH ROD LINK

DART AEROSPACE	
TITLE VERTICAL CAPTURE TRANSPORT	
DWG NO. VCT-3-35	REV 2
MAT'L 4140/4142	DRAWN BY: CLOUGH
UNLESS OTHERWISE SPECIFIED DIMENSIONS ARE IN INCHES	APPROVED <i>J. Gilbert</i>
.XXX ± .005	HEAT TREAT RC 35-39
.XX ± .01	FINISH SEE NOTE 1
.X ± .1	ANGLES ± 5°
1. BREAK ALL SHARP EDGES .015 x 45° OR .015R	SPEC
2. DIMENSIONAL LIMITS APPLY AFTER PLATING	USED ON MODEL
SCALE 1:2	DATE 12/2/2014
SHEET 20 OF 57	

This drawing, specifications, and concepts contained here in are the sole property of Dart Aerospace, and may not be reproduced or used in any fashion without the prior written permission of Dart Aerospace Eugene, OR.

REVISIONS				
REV	ECR	DESCRIPTION	DATE	INITIAL
				APPROVED

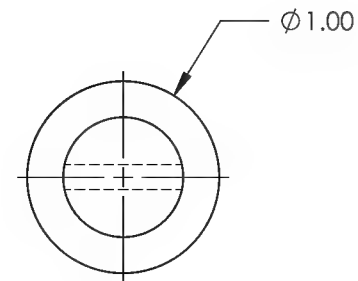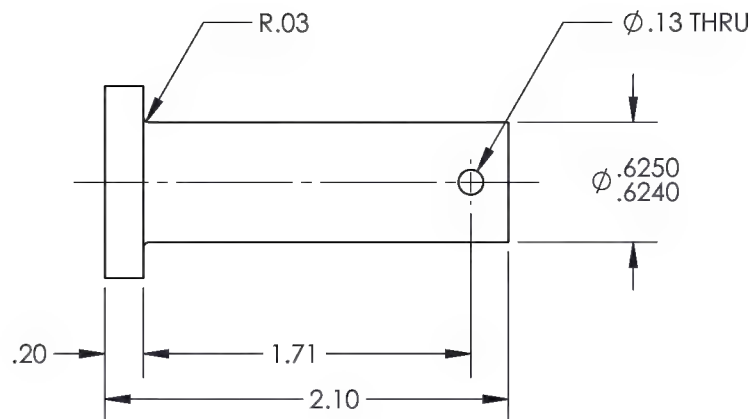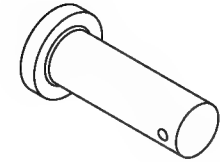

NOTE:
1. NICKEL PLATE .0004 - .0006, BAKE AFTER PLATING.




(-37)

PIN, PUSH ROD LINK

DART AEROSPACE	
TITLE VERTICAL CAPTURE TRANSPORT	
DWG NO. VCT-3-37	REV 2
MAT'L 4140/4142 Q&T	DRAWN BY: CLOUGH
UNLESS OTHERWISE SPECIFIED DIMENSIONS ARE IN INCHES	APPROVED <i>J Gilbert</i>
.XXX ± .005	HEAT TREAT
.XX ± .01	FINISH SEE NOTE 1
.X ± .1	ANGLES ± 5°
1. BREAK ALL SHARP EDGES .015 x 45° OR .015R	SPEC
2. DIMENSIONAL LIMITS APPLY AFTER PLATING	USED ON MODEL
SCALE 1:1	DATE 12/2/2014
SHEET 21 OF 57	

This drawing, specifications, and concepts contained here in are the sole property of Dart Aerospace, and may not be reproduced or used in any fashion without the prior written permission of Dart Aerospace Eugene, OR.

REVISIONS				
REV	ECR	DESCRIPTION	DATE	INITIAL
				APPROVED

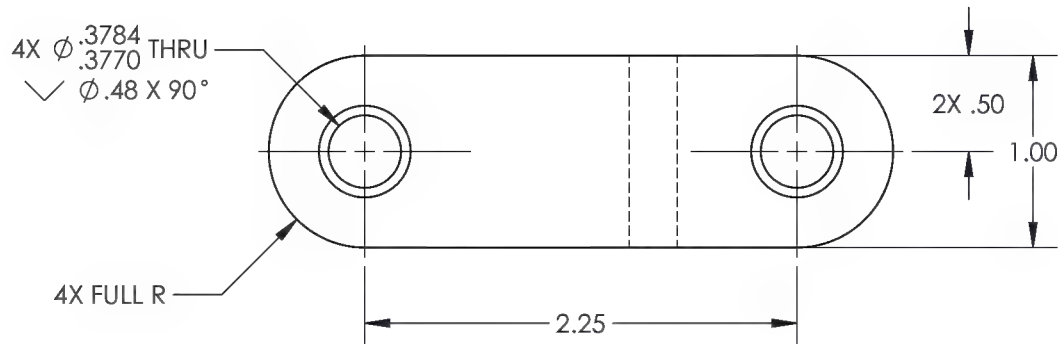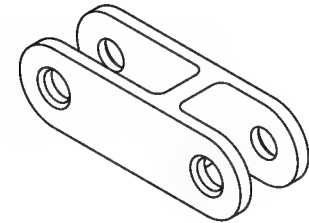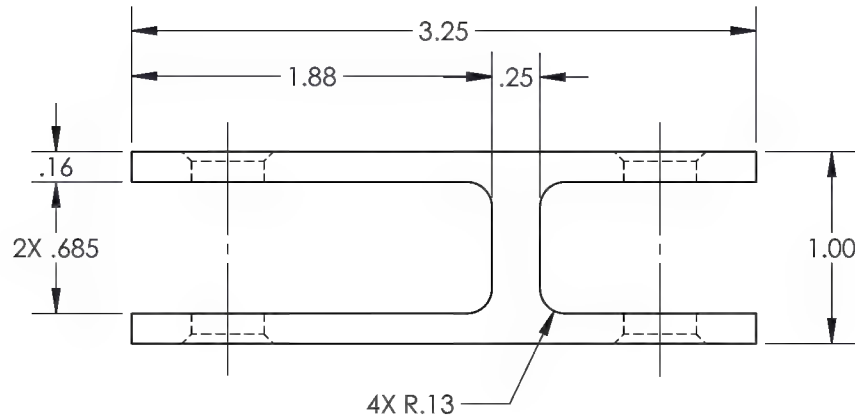

(-39)



LINK

NOTE:
1. NICKEL PLATE .0004 - .0006, BAKE AFTER PLATING.

DART AEROSPACE	
TITLE VERTICAL CAPTURE TRANSPORT	
DWG NO. VCT-3-39	REV 2
MAT'L 4140/4142	DRAWN BY: CLOUGH
UNLESS OTHERWISE SPECIFIED DIMENSIONS ARE IN INCHES	APPROVED <i>J. Gilbert</i>
.XXX ± .005	HEAT TREAT RC 35-39
.XX ± .01	FINISH SEE NOTE 1
.X ± .1	ANGLES ± 5°
1. BREAK ALL SHARP EDGES .015 x 45° OR .015R	SPEC
2. DIMENSIONAL LIMITS APPLY AFTER PLATING	USED ON MODEL
SCALE 1:1	DATE 12/2/2014
SHEET 22 OF 57	

This drawing, specifications, and concepts contained here in are the sole property of Dart Aerospace, and may not be reproduced or used in any fashion without the prior written permission of Dart Aerospace Eugene, OR.

REVISIONS				
REV	ECR	DESCRIPTION	DATE	INITIAL

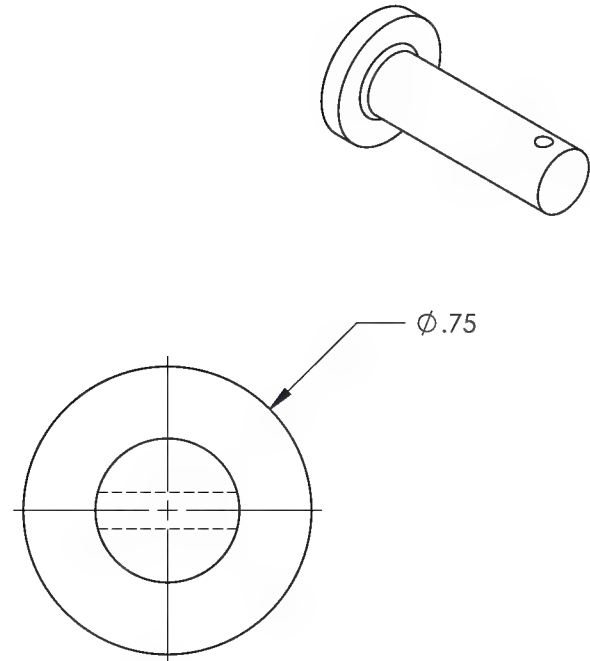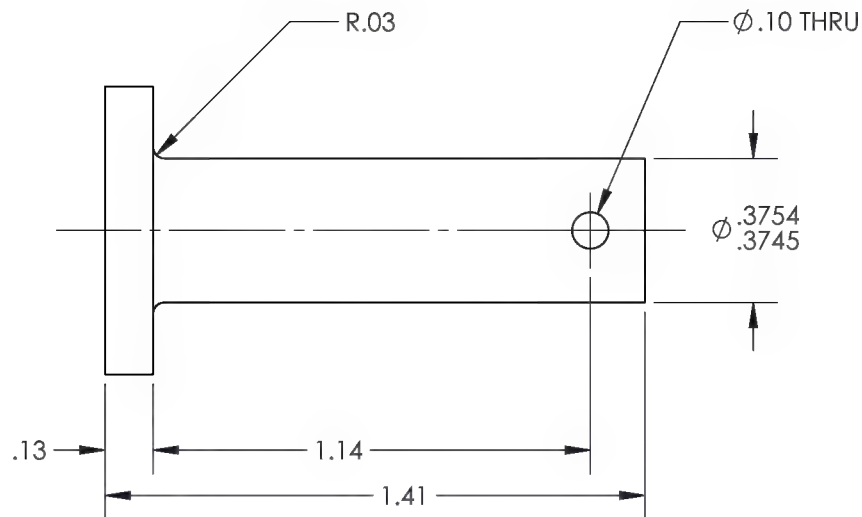



NOTE:
1. NICKEL PLATE .0004 - .0006, BAKE AFTER PLATING.

(-41)
PIN, LINK


DART AEROSPACE	
TITLE VERTICAL CAPTURE TRANSPORT	
DWG NO. VCT-3-41	REV 2
MAT'L 4140/4142 Q&T	DRAWN BY: CLOUGH
UNLESS OTHERWISE SPECIFIED DIMENSIONS ARE IN INCHES	APPROVED <i>J Gilbert</i>
.XXX ± .005	HEAT TREAT
.XX ± .01	FINISH SEE NOTE 1
.X ± .1	ANGLES ± 5°
1. BREAK ALL SHARP EDGES .015 x 45° OR .015R	SPEC
2. DIMENSIONAL LIMITS APPLY AFTER PLATING	USED ON MODEL
SCALE 2:1	DATE 12/2/2014
SHEET 23 OF 57	

This drawing, specifications, and concepts contained here in are the sole property of Dart Aerospace, and may not be reproduced or used in any fashion without the prior written permission of Dart Aerospace Eugene, OR.

REVISIONS				
REV	ECR	DESCRIPTION	DATE	INITIAL

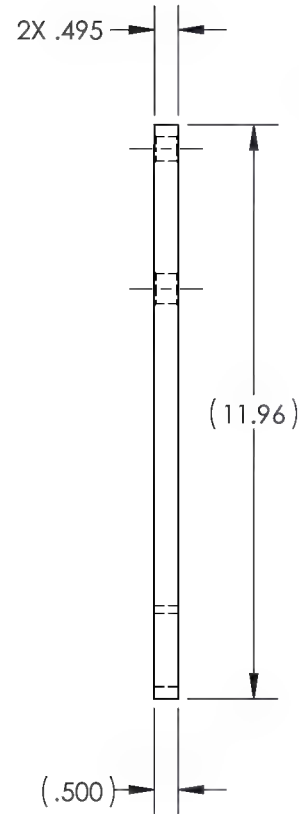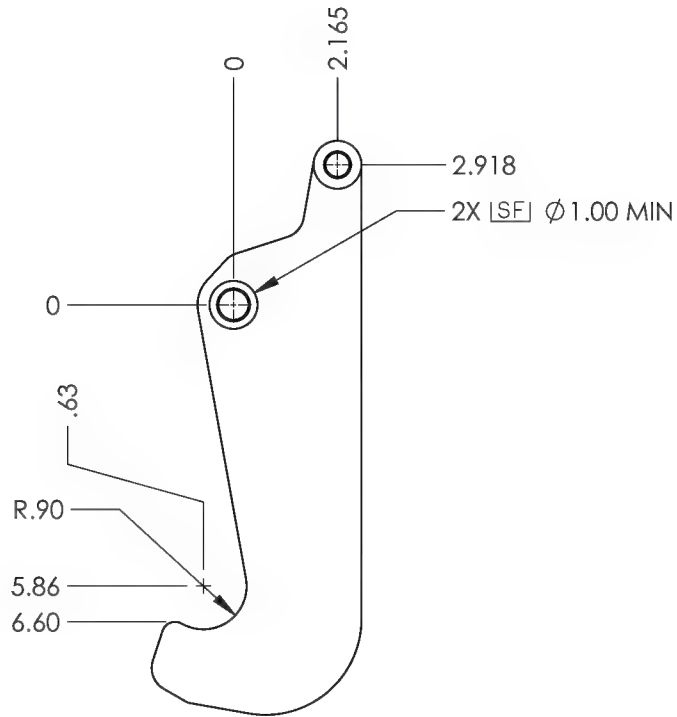

Ø .5019 THRU
Ø .5015 THRU
✓ Ø .56 X 90°
BOTH SIDES

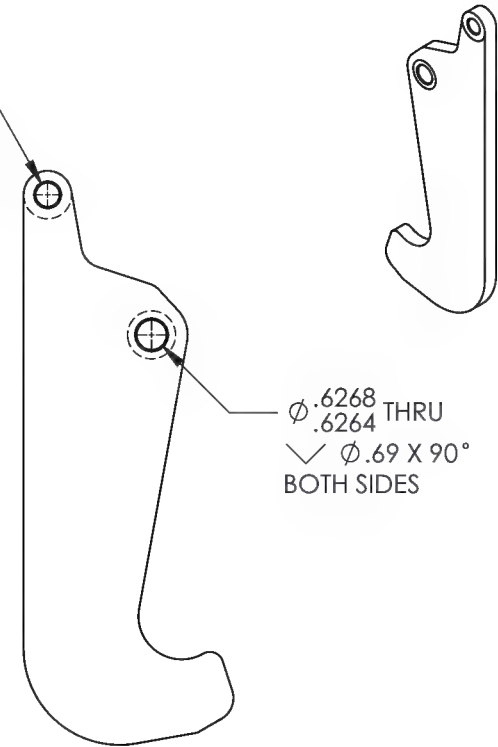




NOTE:
1. NICKEL PLATE .0004 - .0006, BAKE AFTER PLATING.
2. USE DXF PROFILE FOR PART CONTOURS.

(-43)
ARM

DART AEROSPACE	
TITLE VERTICAL CAPTURE TRANSPORT	
DWG NO. VCT-3-43	REV 2
MAT'L 4140/4142	DRAWN BY: CLOUGH
UNLESS OTHERWISE SPECIFIED DIMENSIONS ARE IN INCHES	APPROVED <i>J. Gilbert</i>
.XXX ± .005 FRACTIONS ± 1/8	HEAT TREAT RC 48-52
.XX ± .01 ANGLES ± 5°	FINISH SEE NOTE 1
.X ± .1	SPEC
1. BREAK ALL SHARP EDGES .015 x 45° OR .015R	USED ON MODEL
2. DIMENSIONAL LIMITS APPLY AFTER PLATING	
SCALE 1:4	DATE 12/2/2014
SHEET 24 OF 57	

This drawing, specifications, and concepts contained here in are the sole property of Dart Aerospace, and may not be reproduced or used in any fashion without the prior written permission of Dart Aerospace Eugene, OR.

REVISIONS				
REV	ECR	DESCRIPTION	DATE	INITIAL

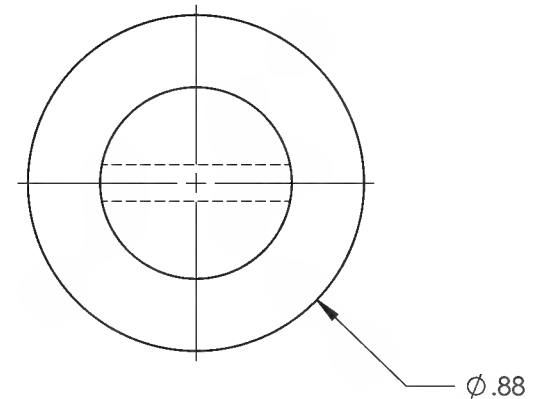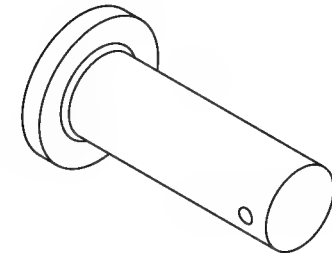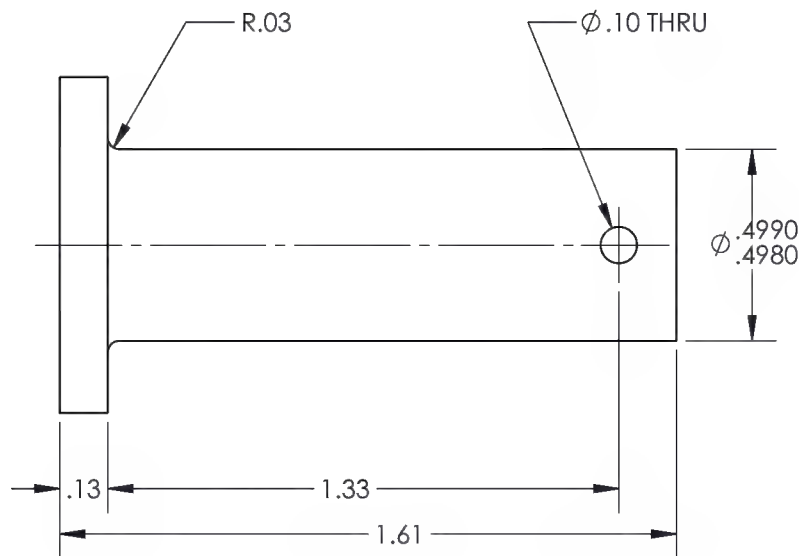

NOTE:
1. NICKEL PLATE .0004 - .0006, BAKE AFTER PLATING.





(-45)

PIN, ARM

DART AEROSPACE	
TITLE VERTICAL CAPTURE TRANSPORT	
DWG NO. VCT-3-45	REV 2
MAT'L 4140/4142 Q&T	DRAWN BY: DUERFELDT
UNLESS OTHERWISE SPECIFIED DIMENSIONS ARE IN INCHES	APPROVED <i>J Gilbert</i>
.XXX \pm .005	HEAT TREAT
.XX \pm .01	FINISH SEE NOTE 1
.X \pm .1	ANGLES $\pm 5^\circ$
1. BREAK ALL SHARP EDGES .015 x 45° OR .015R	SPEC
2. DIMENSIONAL LIMITS APPLY AFTER PLATING	USED ON MODEL
SCALE 2:1	DATE 12/2/2014
SHEET 25 OF 57	

This drawing, specifications, and concepts contained here in are the sole property of Dart Aerospace, and may not be reproduced or used in any fashion without the prior written permission of Dart Aerospace Eugene, OR.

REVISIONS				
REV	ECR	DESCRIPTION	DATE	INITIAL
				APPROVED

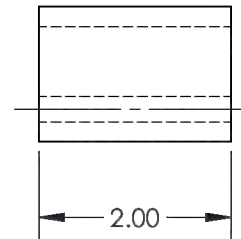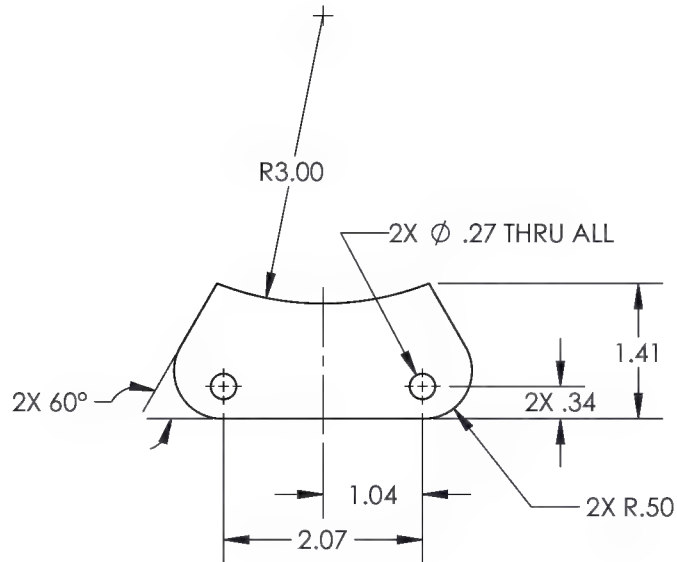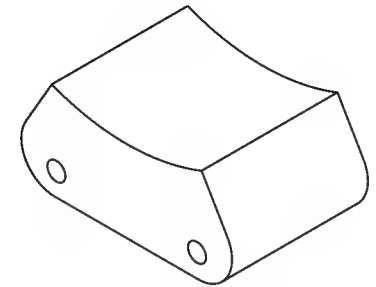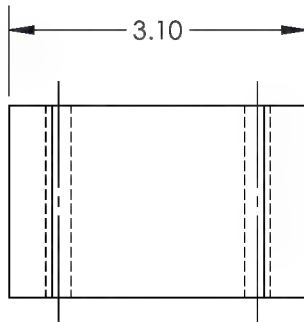


(-47)

ANCHOR GUARD

DART AEROSPACE	
TITLE VERTICAL CAPTURE TRANSPORT	
DWG NO. VCT-3-47	REV 2
MAT'L 6061	DRAWN BY: CLOUGH
UNLESS OTHERWISE SPECIFIED DIMENSIONS ARE IN INCHES	APPROVED <i>J Gilbert</i>
.XXX ± .005 FRACTIONS ± 1/8	HEAT TREAT
.XX ± .01 ANGLES ± 5°	FINISH CLEAR ANODIZE
.X ± .1	SPEC MIL-A-8625F, TYPE II, CLASS I
1. BREAK ALL SHARP EDGES .015 x 45° OR .015R	USED ON MODEL
2. DIMENSIONAL LIMITS APPLY AFTER PLATING	
SCALE 1:2	DATE 12/4/2014
SHEET 26 OF 57	


This drawing, specifications, and concepts contained here in are the sole property of Dart Aerospace, and may not be reproduced or used in any fashion without the prior written permission of Dart Aerospace Eugene, OR.

REVISIONS					
REV	ECR	DESCRIPTION	DATE	INITIAL	APPROVED
2	15-0149	-49 CH'D TITLEBLOCK TOLERANCES.	6/22/2015	PMW	JAG

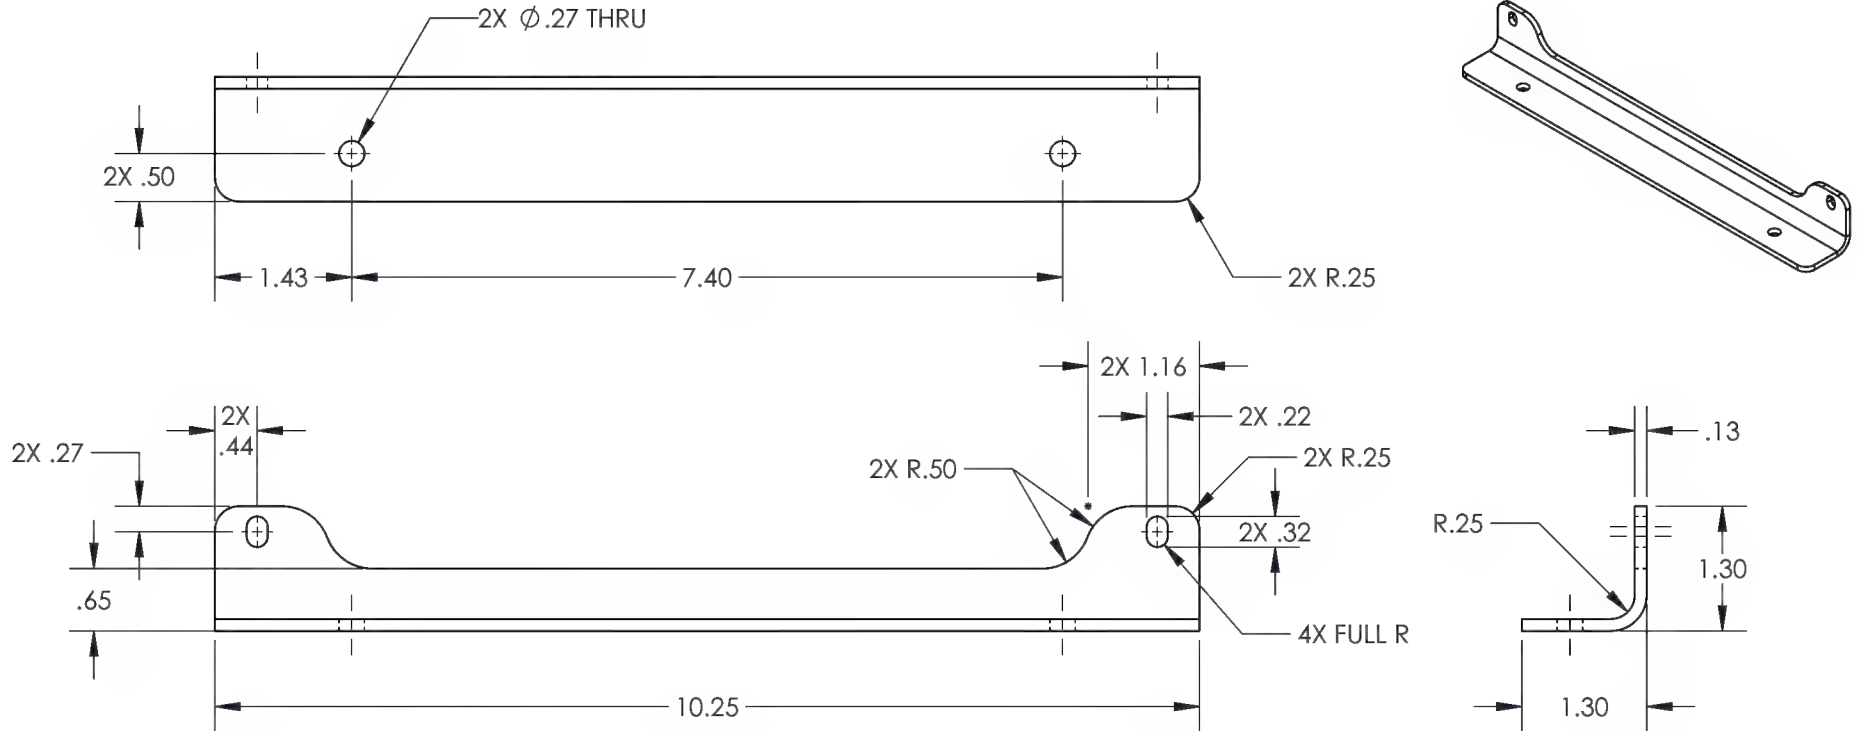

-49



BRACKET, BOX

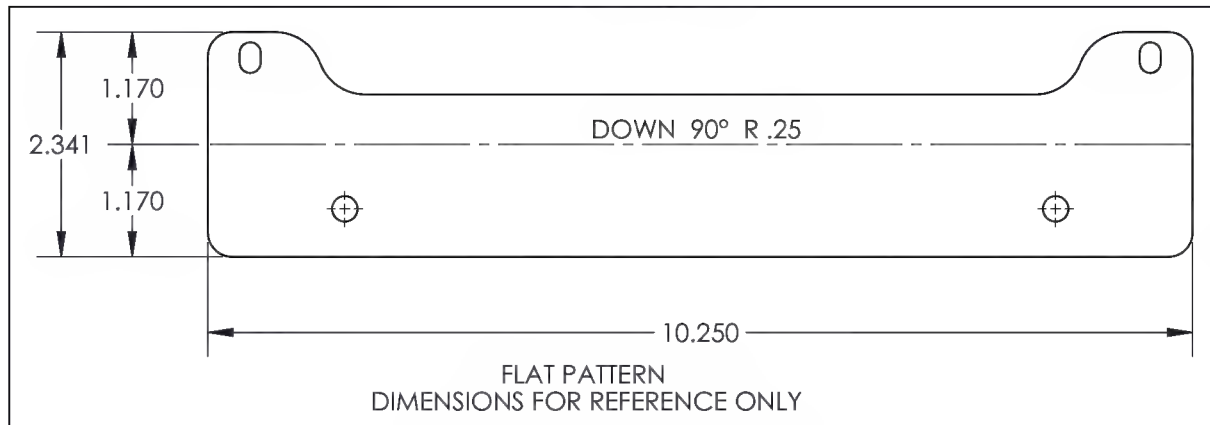

TITLE VERTICAL CAPTURE TRANSPORT		
DWG NO.	VCT-3-49	REV 2
MAT'L 1018	DRAWN BY: CLOUGH	
UNLESS OTHERWISE SPECIFIED DIMENSIONS ARE IN INCHES	APPROVED <i>R. Clough</i>	
.XXX ± .010	HEAT TREAT	
.XX ± .03	FINISH	POWDER COAT
.X ± .1	SPEC	GLOSS WHITE
1. BREAK ALL SHARP EDGES .015 x 45° OR .015R	USED ON MODEL	
2. DIMENSIONAL LIMITS APPLY AFTER PLATING		
SCALE 1:2	DATE 12/2/2014	SHEET 27 OF 57

This drawing, specifications, and concepts contained here in are the sole property of Dart Aerospace, and may not be reproduced or used in any fashion without the prior written permission of Dart Aerospace Eugene, OR.

REVISIONS				
REV	ECR	DESCRIPTION	DATE	INITIAL
				APPROVED

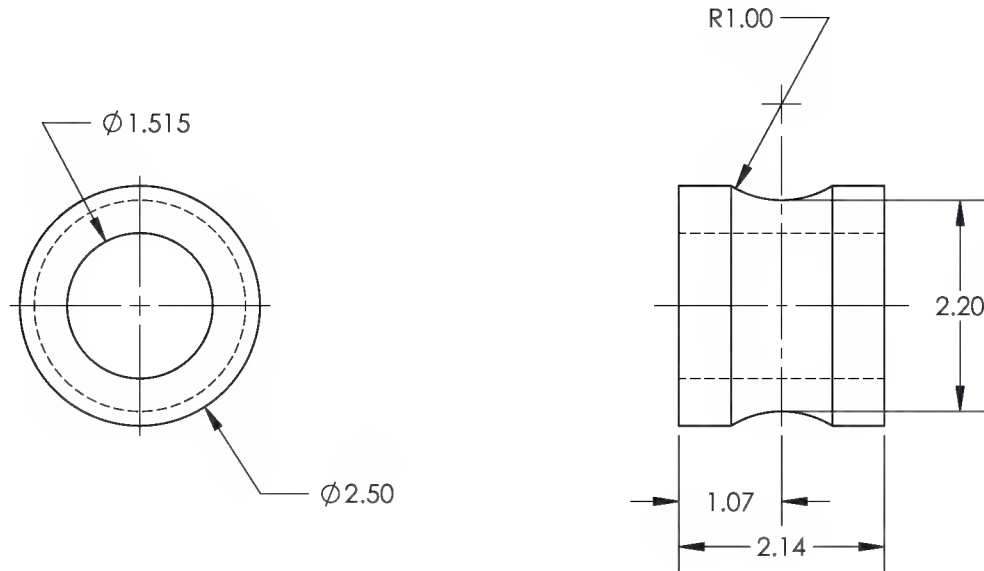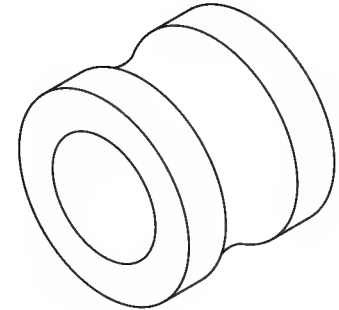



NOTE:
1. NICKEL PLATE .0004 - .0006, BAKE AFTER PLATING.

(51)
LIFTING BUSHING

DART AEROSPACE	
TITLE VERTICAL CAPTURE TRANSPORT	
DWG NO. VCT-3-51	REV 2
MAT'L 4140/4142 Q&T	DRAWN BY: DUERFELDT
UNLESS OTHERWISE SPECIFIED DIMENSIONS ARE IN INCHES	APPROVED <i>J Gilbert</i>
.XXX ± .005 FRACTIONS ± 1/8	HEAT TREAT
.XX ± .01 ANGLES ± 5°	FINISH SEE NOTE 1
.X ± .1	SPEC
1. BREAK ALL SHARP EDGES .015 x 45° OR .015R	USED ON MODEL
2. DIMENSIONAL LIMITS APPLY AFTER PLATING	
SCALE 1:2	DATE 12/2/2014
SHEET 28 OF 57	

This drawing, specifications, and concepts contained here in are the sole property of Dart Aerospace, and may not be reproduced or used in any fashion without the prior written permission of Dart Aerospace Eugene, OR.

REVISIONS				
REV	ECR	DESCRIPTION	DATE	INITIAL
				APPROVED

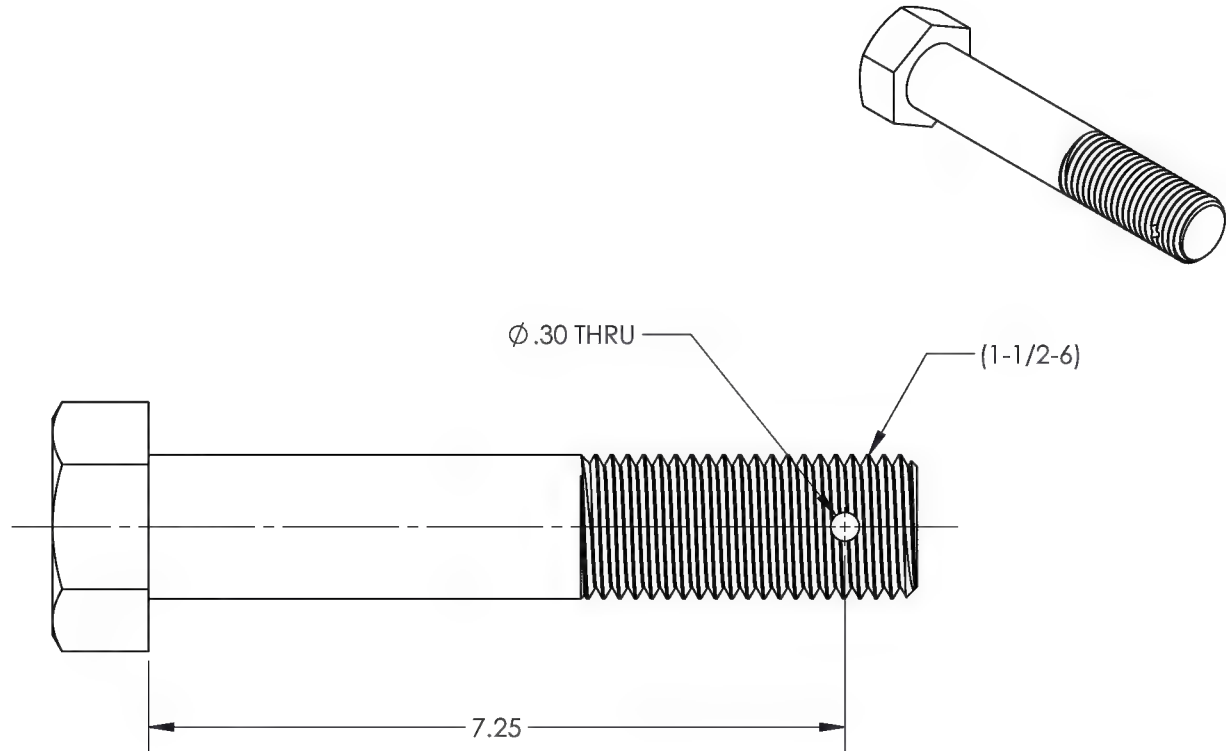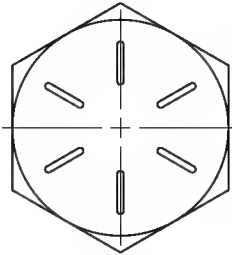



NOTE:
1. NICKEL PLATE .0004 - .0006, BAKE AFTER PLATING.

(53)
LIFTING BOLT


DART AEROSPACE	
TITLE VERTICAL CAPTURE TRANSPORT	
DWG NO. VCT-3-53	REV 2
MAT'L STEEL	DRAWN BY: CLOUGH
UNLESS OTHERWISE SPECIFIED DIMENSIONS ARE IN INCHES	APPROVED <i>J Gilbert</i>
.XXX ± .005	HEAT TREAT
.XX ± .01	FINISH SEE NOTE 1
.X ± .1	ANGLES ± 5°
1. BREAK ALL SHARP EDGES .015 x 45° OR .015R	SPEC
2. DIMENSIONAL LIMITS APPLY AFTER PLATING	USED ON MODEL
SCALE 1:2	DATE 12/4/2014
SHEET 29 OF 57	

This drawing, specifications, and concepts contained here in are the sole property of Dart Aerospace, and may not be reproduced or used in any fashion without the prior written permission of Dart Aerospace Eugene, OR.


REVISIONS					
REV	ECR	DESCRIPTION	DATE	INITIAL	APPROVED
1	15-0005	MOVED HOLES FROM 16.91 TO 17.91	1/6/2015	PW	JG
2	15-0149	-55 ADDED CHAMFER 2X .30 X 45°. DELETED HOLES 4X Ø.194. ADDED HOLES 2X Ø.28. ADDED TAB.	6/22/2015	PMW	JAG

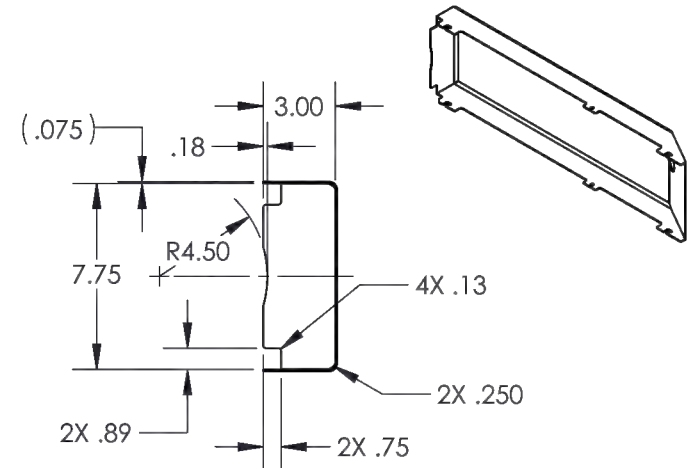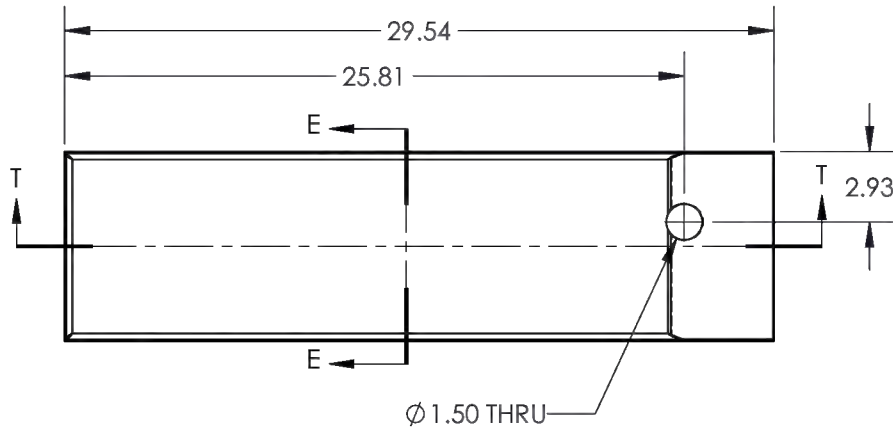


SECTION E-E

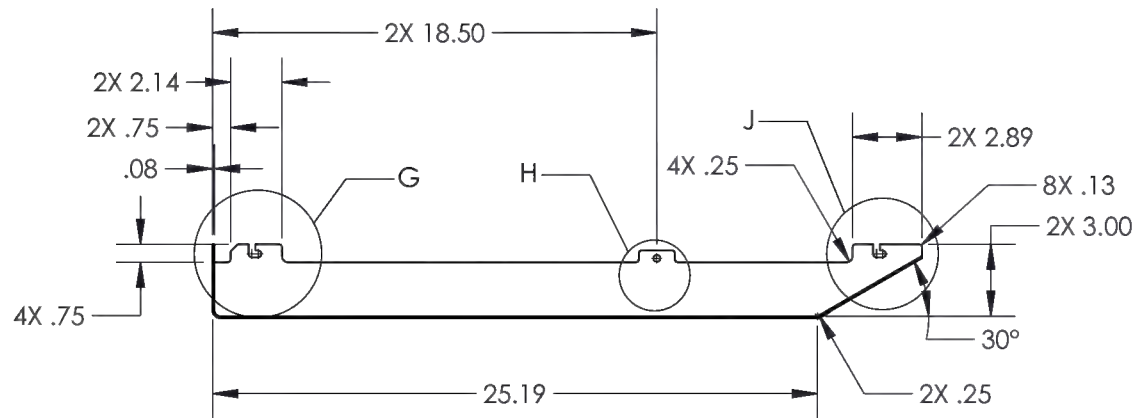


SECTION T-T

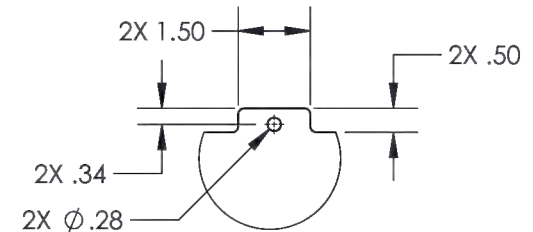

DETAIL H
SCALE 1 : 4

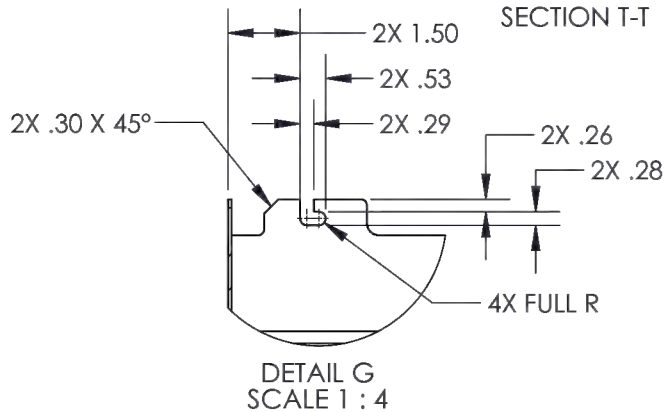

DETAIL G
SCALE 1 : 4

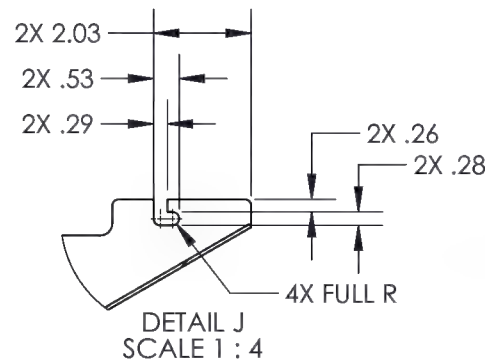

DETAIL J
SCALE 1 : 4



-55
COVER

NOTE:
WELD ALL SEAMS AND CORNERS.

DART AEROSPACE	
TITLE VERTICAL CAPTURE TRANSPORT	
DWG NO. VCT-3-55	REV 2
MAT'L 1018	DRAWN BY: GILBERT
UNLESS OTHERWISE SPECIFIED DIMENSIONS ARE IN INCHES	APPROVED <i>J Gilbert</i>
.XXX ± .010 FRACTIONS ± 1/8	HEAT TREAT
.XX ± .03 ANGLES ± 5°	FINISH POWDER COAT
.X ± .1	SPEC GLOSS WHITE
1. BREAK ALL SHARP EDGES .015 x 45° OR .015R	USED ON MODEL
2. DIMENSIONAL LIMITS APPLY AFTER PLATING	
SCALE 1:8	DATE 8/5/2014
SHEET 30 OF 57	

This drawing, specifications, and concepts contained here in are the sole property of Dart Aerospace, and may not be reproduced or used in any fashion without the prior written permission of Dart Aerospace Eugene, OR.

REVISIONS					
REV	ECR	DESCRIPTION	DATE	INITIAL	APPROVED

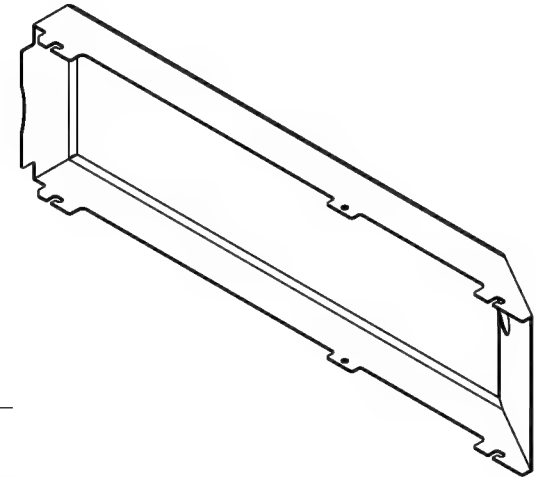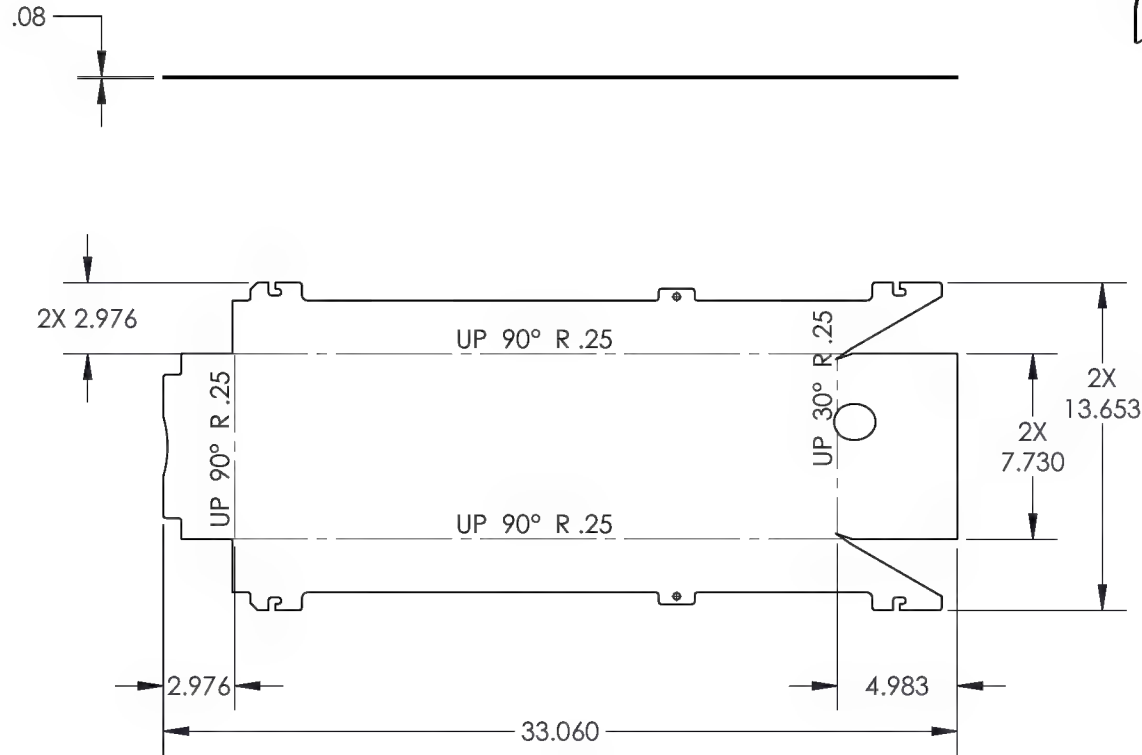

DIMENSIONS FOR REFERENCE ONLY



-55A

COVER FLAT PATTERN


DART AEROSPACE	
TITLE VERTICAL CAPTURE TRANSPORT	
DWG NO. VCT-3-55A	REV 2
MAT'L 1018	DRAWN BY: GILBERT
UNLESS OTHERWISE SPECIFIED DIMENSIONS ARE IN INCHES	APPROVED <i>J Gilbert</i>
.XXX ± .010 FRACTIONS ± 1/8	HEAT
.XX ± .03 ANGLES ± 5°	TREAT
.X ± .1	FINISH
1. BREAK ALL SHARP EDGES .015 x 45° OR .015R	SPEC
2. DIMENSIONAL LIMITS APPLY AFTER PLATING	USED ON MODEL
SCALE 1:8	DATE 8/5/2014
SHEET 31 OF 57	

This drawing, specifications, and concepts contained here in are the sole property of Dart Aerospace, and may not be reproduced or used in any fashion without the prior written permission of Dart Aerospace Eugene, OR.


REVISIONS					
REV	ECR	DESCRIPTION	DATE	INITIAL	APPROVED
1	15-0005	MOVED HOLES FROM 16.91 TO 17.91	1/6/2015	PW	JG
2	15-0149	-57 ADDED CHAMFER 2X .30 X 45°. DELETED HOLES 4X Ø.194. ADDED HOLES 2X Ø.28. ADDED TAB.	6/22/2015	PMW	JAG

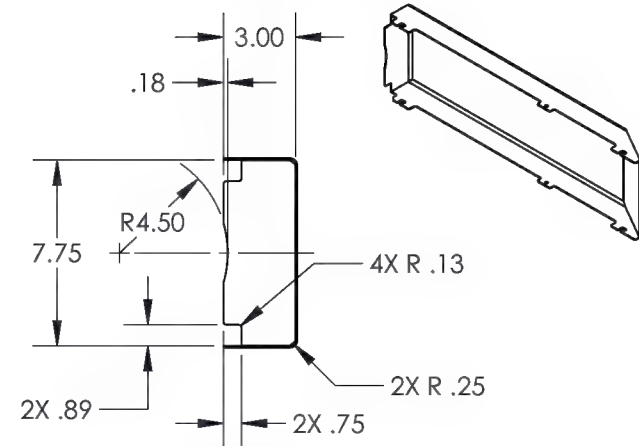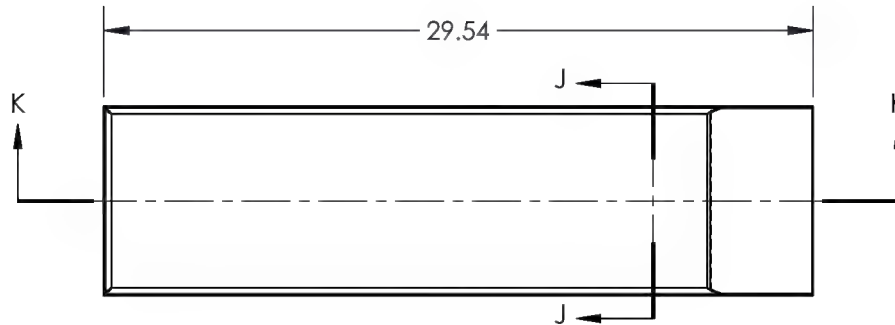


SECTION J-J

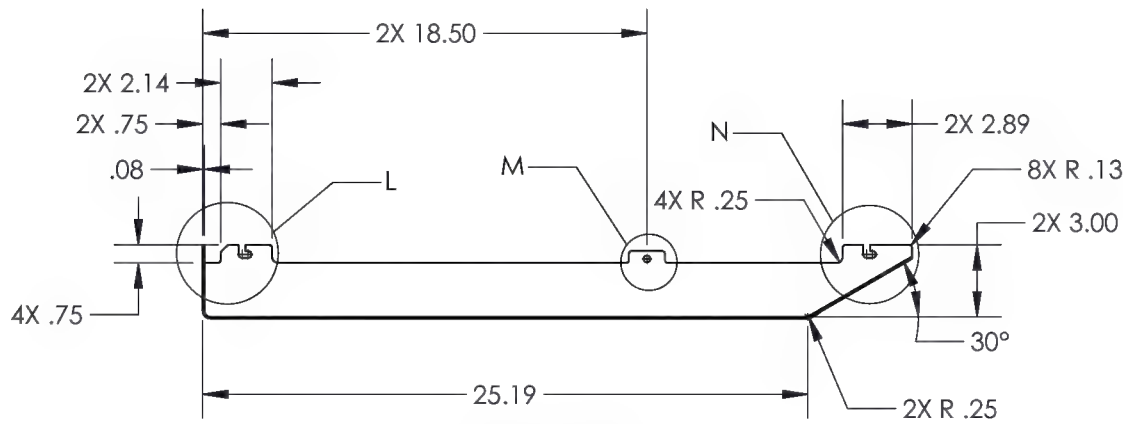


SECTION K-K

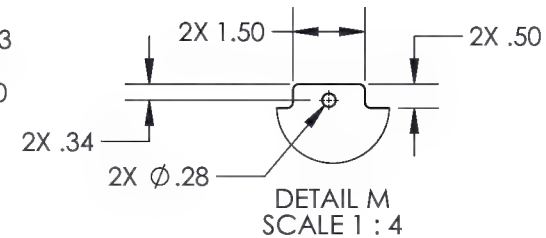

DETAIL M
SCALE 1 : 4

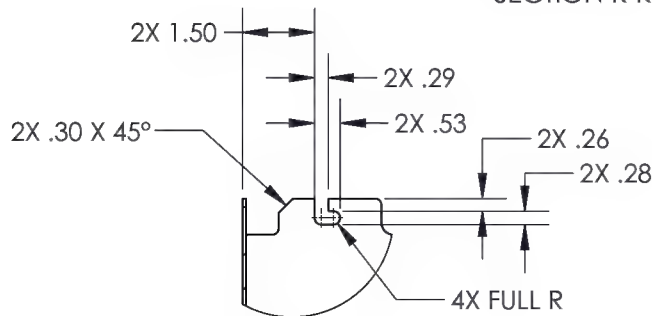

DETAIL L
SCALE 1 : 4

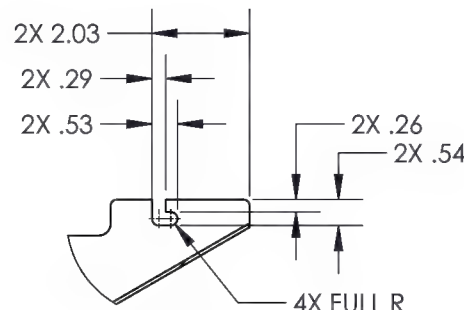

DETAIL N
SCALE 1 : 4



(-57)
COVER

NOTE:
WELD ALL SEAMS AND CORNERS.

DART AEROSPACE	
TITLE VERTICAL CAPTURE TRANSPORT	
DWG NO. VCT-3-57	REV 2
MAT'L 1018	DRAWN BY: GILBERT
UNLESS OTHERWISE SPECIFIED DIMENSIONS ARE IN INCHES	APPROVED <i>J Gilbert</i>
.XXX ± .010 FRACTIONS ± 1/8	HEAT TREAT
.XX ± .03 ANGLES ± 5°	FINISH POWDER COAT
.X ± .1	SPEC GLOSS WHITE
1. BREAK ALL SHARP EDGES .015 x 45° OR .015R	USED ON MODEL
2. DIMENSIONAL LIMITS APPLY AFTER PLATING	
SCALE 1:8	DATE 8/5/2014
SHEET 32 OF 57	

This drawing, specifications, and concepts contained here in are the sole property of Dart Aerospace, and may not be reproduced or used in any fashion without the prior written permission of Dart Aerospace Eugene, OR.

REVISIONS			
REV	ECR	DESCRIPTION	DATE
			INITIAL
			APPROVED

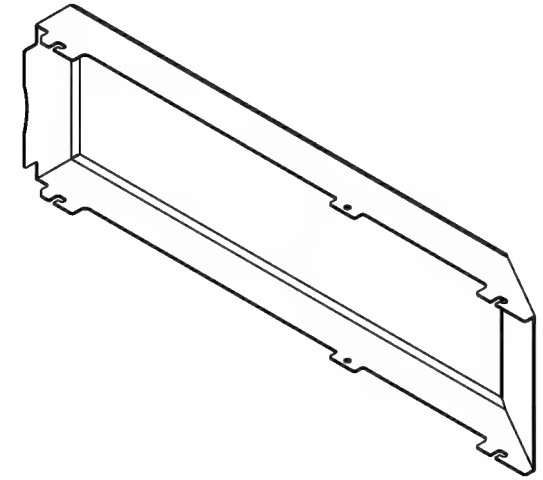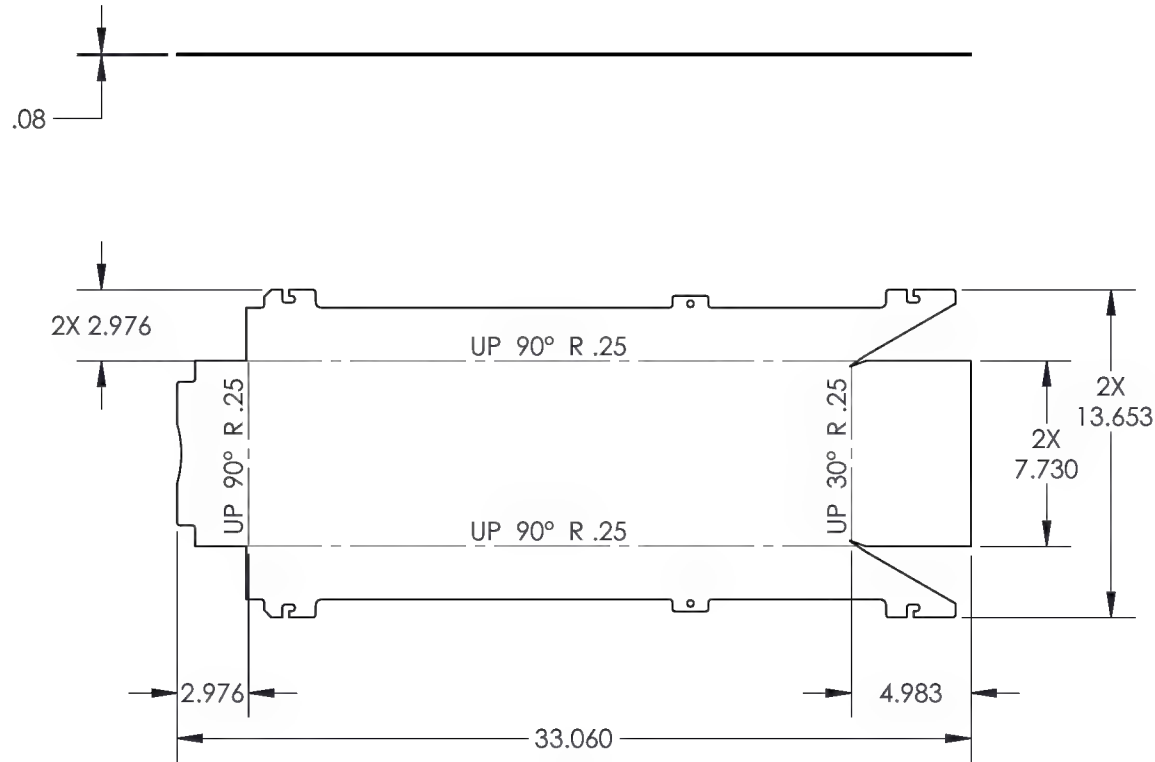

DIMENSIONS FOR REFERENCE ONLY




-57A

COVER FLAT PATTERN

DART AEROSPACE	
TITLE VERTICAL CAPTURE TRANSPORT	
DWG NO. VCT-3-57A	REV 2
MAT'L 1018	DRAWN BY: GILBERT
UNLESS OTHERWISE SPECIFIED DIMENSIONS ARE IN INCHES	APPROVED <i>J Gilbert</i>
.XXX ± .010 FRACTIONS ± 1/8	HEAT
.XX ± .03 ANGLES ± 5°	TREAT
.X ± .1	FINISH
1. BREAK ALL SHARP EDGES .015 x 45° OR .015R	SPEC
2. DIMENSIONAL LIMITS APPLY AFTER PLATING	USED ON MODEL
SCALE 1:8	DATE 8/5/2014
SHEET 33 OF 57	

This drawing, specifications, and concepts contained here in are the sole property of Dart Aerospace, and may not be reproduced or used in any fashion without the prior written permission of Dart Aerospace Eugene, OR.

REVISIONS					
REV	ECR	DESCRIPTION	DATE	INITIAL	APPROVED
1	15-0005	REMOVED 2 HOLES, INCREASED LENGTH TO 17.44 FROM 15.44	1/6/2015	PW	JG
2	15-0149	-59 HOLES SLOTTED, FLANGE INTERFACE IMPROVED.	6/24/2015	PMW	JAG

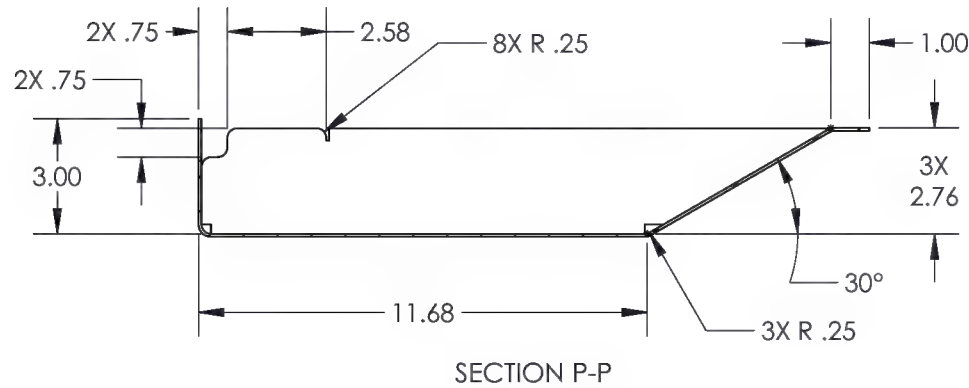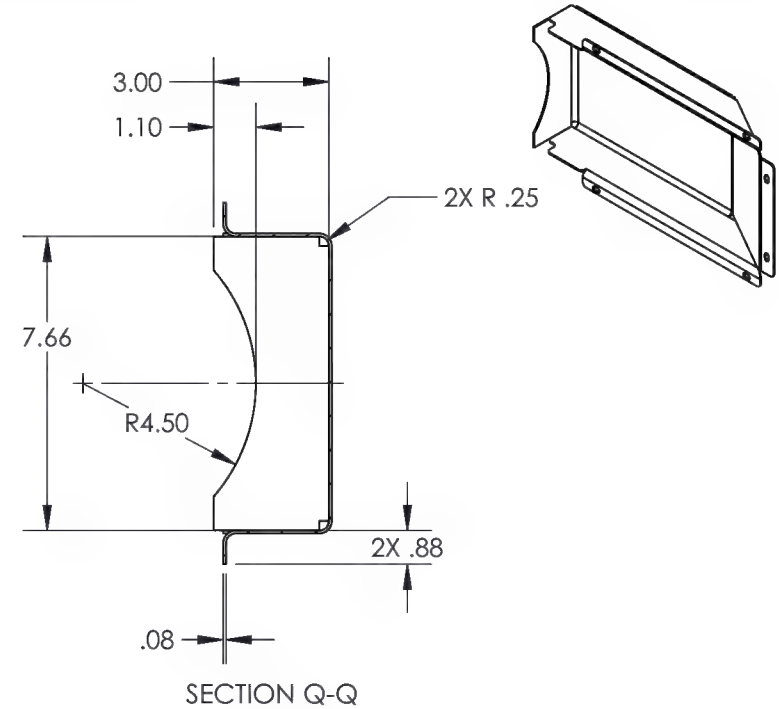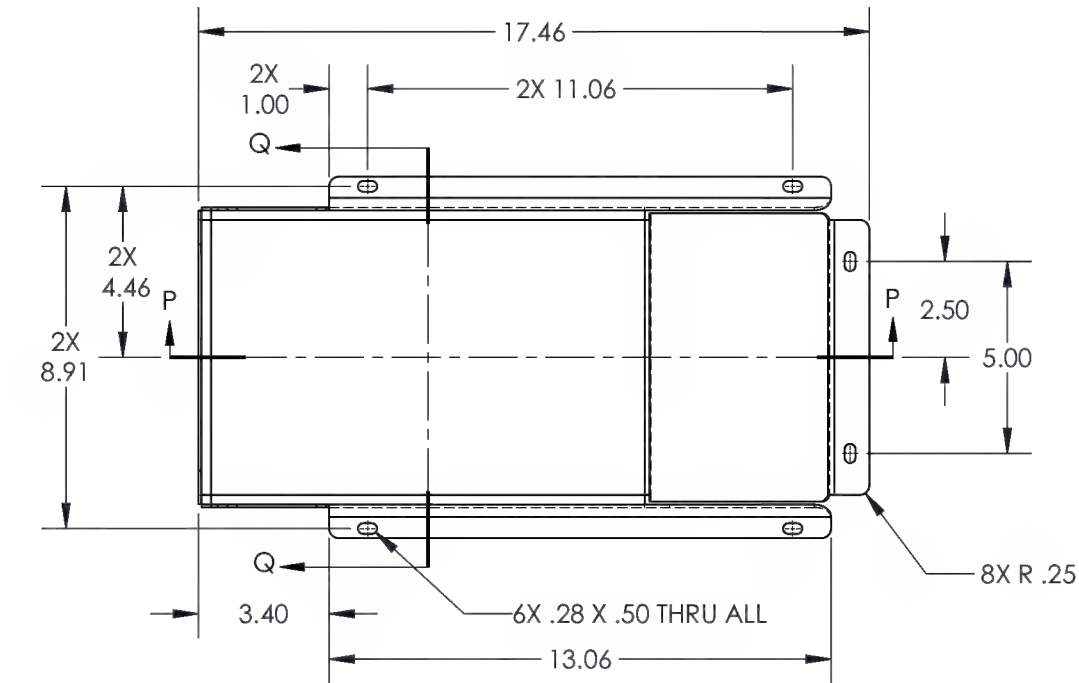



-59
SIDE COVER

NOTE:
WELD ALL SEAMS AND CORNERS.

DART AEROSPACE	
TITLE VERTICAL CAPTURE TRANSPORT	
DWG NO. VCT-3-59	REV 2
MAT'L 1018	DRAWN BY: DUERFELDT
UNLESS OTHERWISE SPECIFIED DIMENSIONS ARE IN INCHES	APPROVED <i>J Gilbert</i>
.XXX ± .010	HEAT TREAT
.XX ± .03	FINISH POWDER COAT
.X ± .1	SPEC GLOSS WHITE
1. BREAK ALL SHARP EDGES .015 x 45° OR .015R	USED ON MODEL
2. DIMENSIONAL LIMITS APPLY AFTER PLATING	
SCALE 1:5	DATE 12/11/2014
SHEET 34 OF 57	

This drawing, specifications, and concepts contained here in are the sole property of Dart Aerospace, and may not be reproduced or used in any fashion without the prior written permission of Dart Aerospace Eugene, OR.

REVISIONS				
REV	ECR	DESCRIPTION	DATE	INITIAL
2	15-0149	-59A CH'D DIM WAS 2X 7.643 IS 7.643. ADDED DIM 7.513.	6/25/2015	

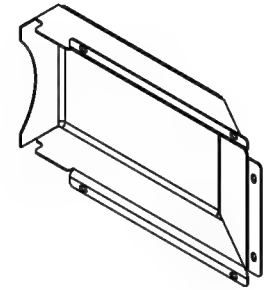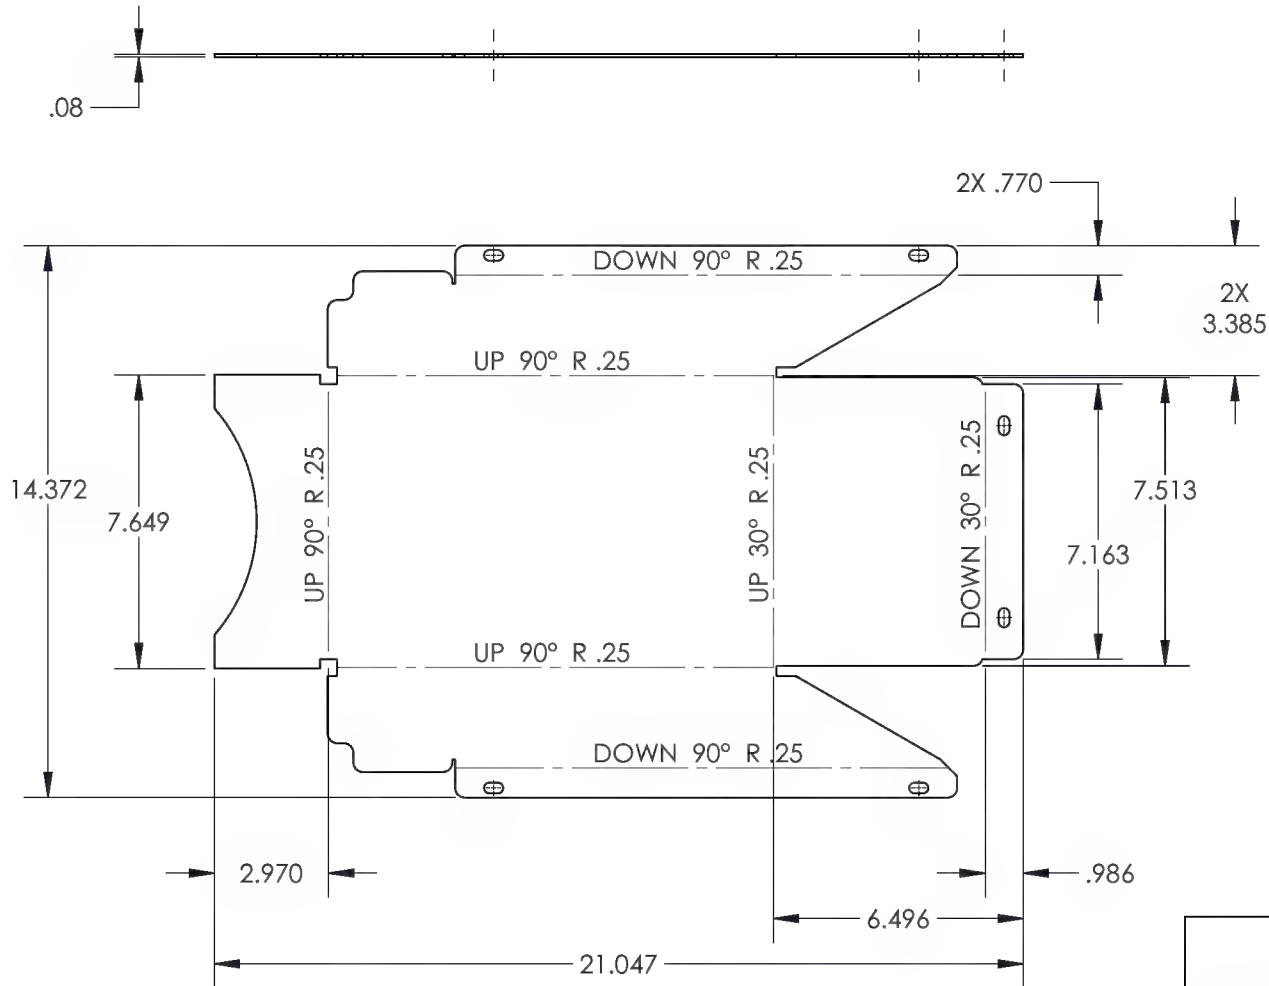

DIMENSIONS FOR REFERENCE ONLY


(-59A)

SIDE COVER FLAT PATTERN

DART AEROSPACE	
TITLE VERTICAL CAPTURE TRANSPORT	
DWG NO. VCT-3-59A	REV 2
MAT'L 1018	DRAWN BY: DUERFELDT
UNLESS OTHERWISE SPECIFIED DIMENSIONS ARE IN INCHES	APPROVED <i>J Gilbert</i>
.XXX ± .010 FRACTIONS ± 1/8	HEAT
.XX ± .03 ANGLES ± 5°	TREAT
.X ± .1	FINISH
1. BREAK ALL SHARP EDGES .015 x 45° OR .015R	SPEC
2. DIMENSIONAL LIMITS APPLY AFTER PLATING	USED ON MODEL
SCALE 1:5	DATE 12/11/2014
SHEET 35 OF 57	


This drawing, specifications, and concepts contained here in are the sole property of Dart Aerospace, and may not be reproduced or used in any fashion without the prior written permission of Dart Aerospace Eugene, OR.

REVISIONS					
REV	ECR	DESCRIPTION	DATE	INITIAL	APPROVED
2	15-0149	-61 CH'D HOLE LOCATION WAS 2.00 IS 1.85, WAS 2.60 IS 2.30. ADDED KNOB -239.	6/22/2015	PMW	JAG

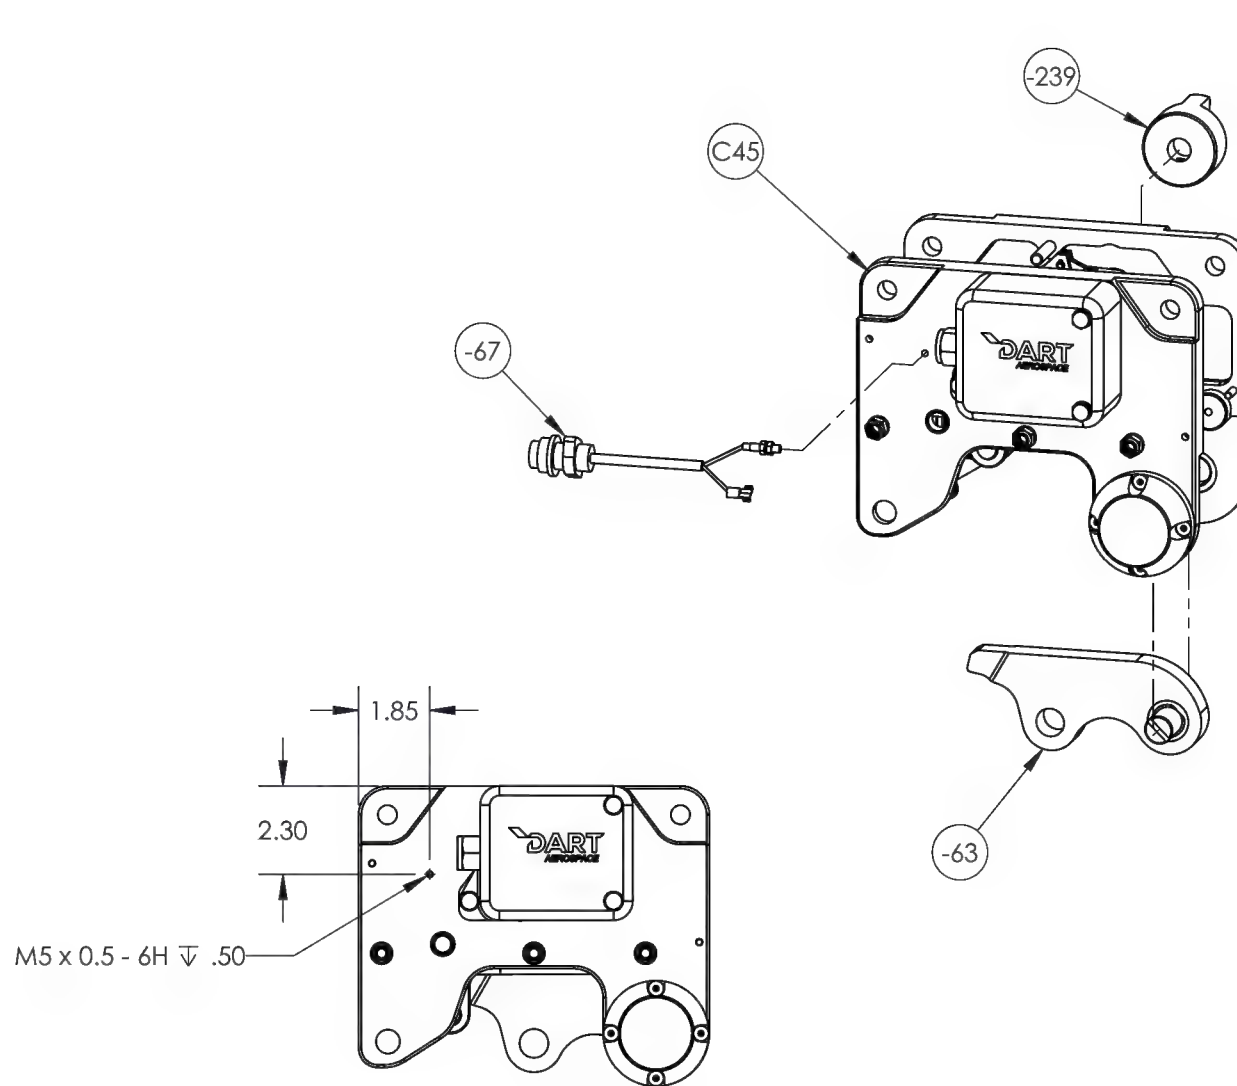

TAP SIDE PLATE C45-11-1

C45 VCT-3 HOOK ASSEMBLY

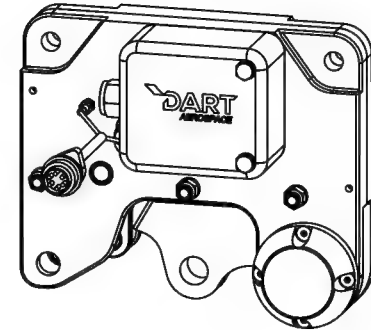


NOTE:
USE A C45 EXCEPT AS SHOWN.

DART AEROSPACE		
TITLE VERTICAL CAPTURE TRANSPORT		
DWG NO. VCT-3-61	REV 2	
MAT'L	DRAWN BY: DUERFELDT	
UNLESS OTHERWISE SPECIFIED DIMENSIONS ARE IN INCHES	APPROVED <i>J Gilbert</i>	
.XXX ± .005	HEAT TREAT	
.XX ± .01	FINISH	
.X ± .1	SPEC	
1. BREAK ALL SHARP EDGES .015 x 45° OR .015R		
2. DIMENSIONAL LIMITS APPLY AFTER PLATING		
SCALE 1:5	DATE 12/4/2014	SHEET 36 OF 57

This drawing, specifications, and concepts contained here in are the sole property of Dart Aerospace, and may not be reproduced or used in any fashion without the prior written permission of Dart Aerospace Eugene, OR.

REVISIONS				
REV	ECR	DESCRIPTION	DATE	INITIAL
				APPROVED

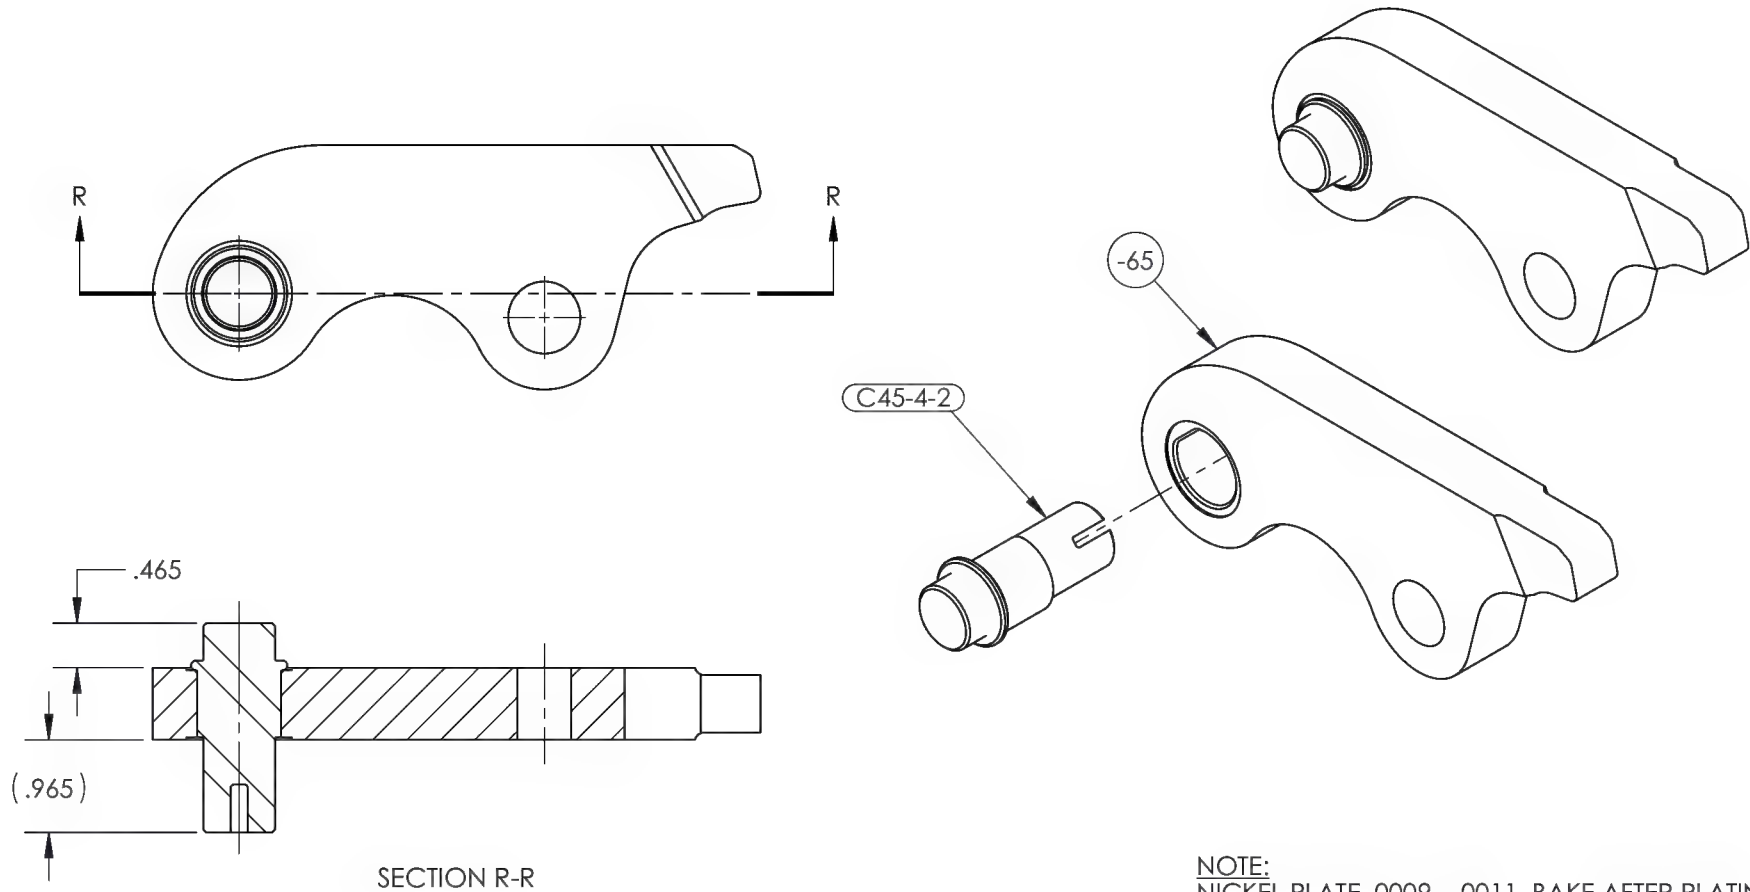


NOTE:
NICKEL PLATE .0009 - .0011, BAKE AFTER PLATING.

(-63)
LOAD BEAM ASSY

DART AEROSPACE	
TITLE VERTICAL CAPTURE TRANSPORT	
DWG NO. VCT-3-63	REV 2
MAT'L	DRAWN BY: DUERFELDT
UNLESS OTHERWISE SPECIFIED DIMENSIONS ARE IN INCHES	APPROVED <i>J Gilbert</i>
.XXX ± .005	HEAT TREAT
.XX ± .01	FINISH SEE NOTE
.X ± .1	SPEC
1. BREAK ALL SHARP EDGES .015 x 45° OR .015R	USED ON MODEL
2. DIMENSIONAL LIMITS APPLY AFTER PLATING	
SCALE 1:2	DATE 12/3/2014
SHEET 37 OF 57	

This drawing, specifications, and concepts contained here in are the sole property of Dart Aerospace, and may not be reproduced or used in any fashion without the prior written permission of Dart Aerospace Eugene, OR.

REVISIONS					
REV	ECR	DESCRIPTION	DATE	INITIAL	APPROVED
2	15-0149	-65 CH'D DIM WAS Ø1.10 \pm .03 IS 2X Ø1.10 \pm .025.	6/22/2015	PMW	JAG

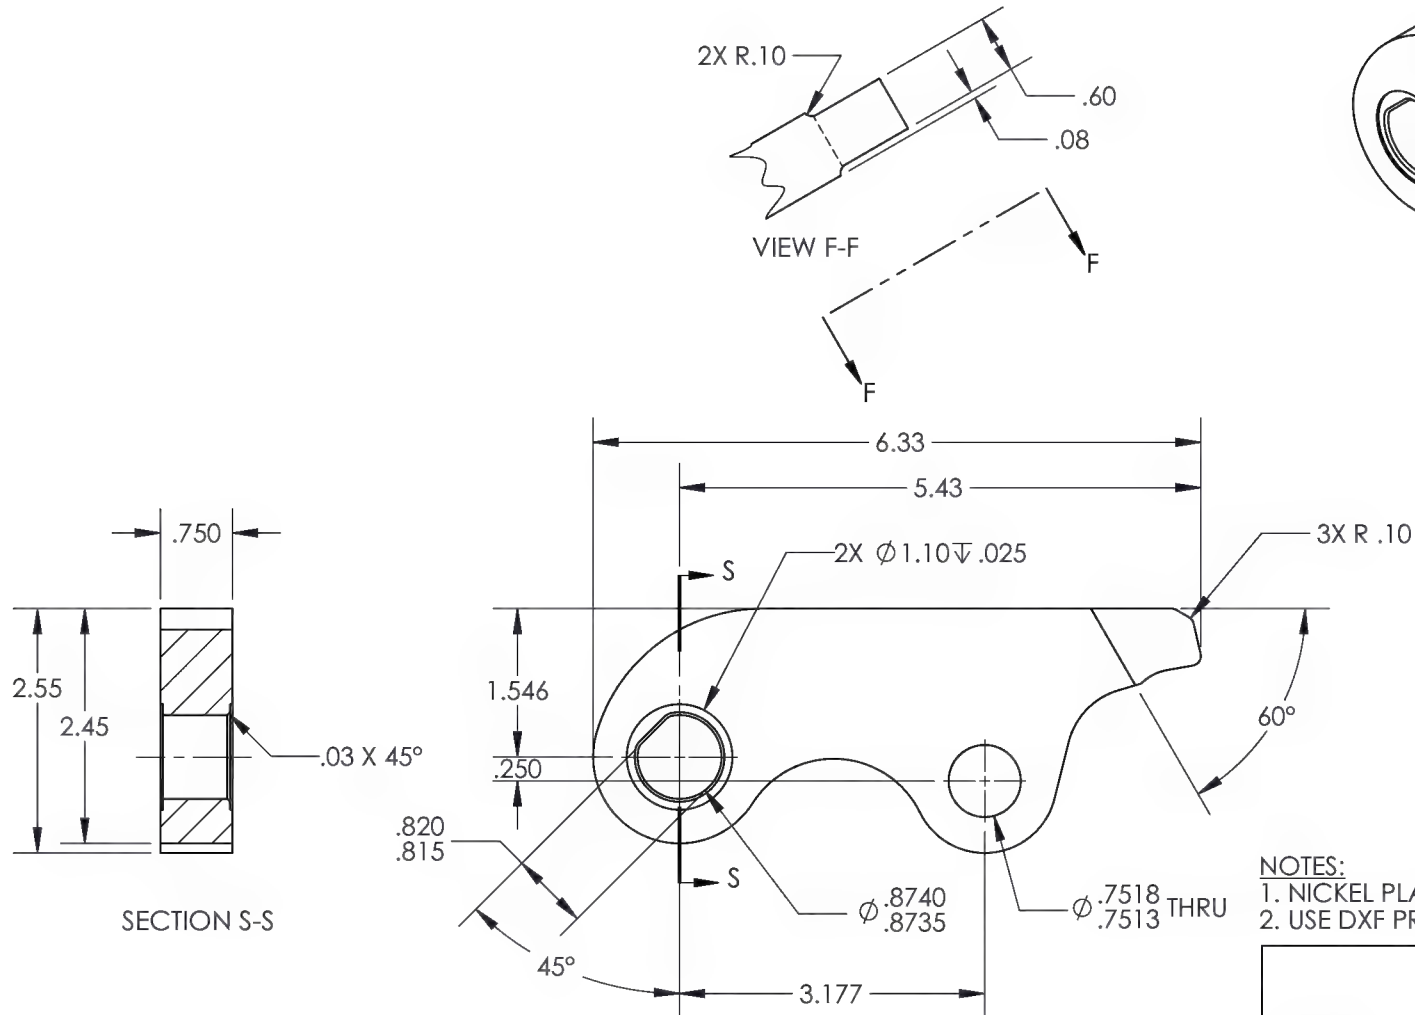

SECTION S-S

NOTES:

1. NICKEL PLATE AFTER ASSEMBLY.
2. USE DXF PROFILE FOR PART CONTOURS.

-65

LOAD BEAM


DART AEROSPACE	
TITLE VERTICAL CAPTURE TRANSPORT	
DWG NO. VCT-3-65	REV 2
MAT'L 4140/4142	DRAWN BY: DUERFELDT
UNLESS OTHERWISE SPECIFIED DIMENSIONS ARE IN INCHES	APPROVED <i>J. Gilbert</i>
.XXX \pm .005	HEAT TREAT RC 50-54
.XX \pm .01	FINISH SEE NOTE 1
.X \pm .1	SPEC
1. BREAK ALL SHARP EDGES .015 x 45° OR .015R	USED ON MODEL
2. DIMENSIONAL LIMITS APPLY AFTER PLATING	
SCALE 1:2	DATE 12/3/2014
SHEET 38 OF 57	

This drawing, specifications, and concepts contained here in are the sole property of Dart Aerospace, and may not be reproduced or used in any fashion without the prior written permission of Dart Aerospace Eugene, OR.

REVISIONS						
REV	ECR	DESCRIPTION	DATE	INITIAL	APPROVED	

WIRING TABLE

-69 PIN	
A	-71
B	-71
C	-73 BLUE WIRE
D	-73 BROWN WIRE
E	-73 BLACK WIRE

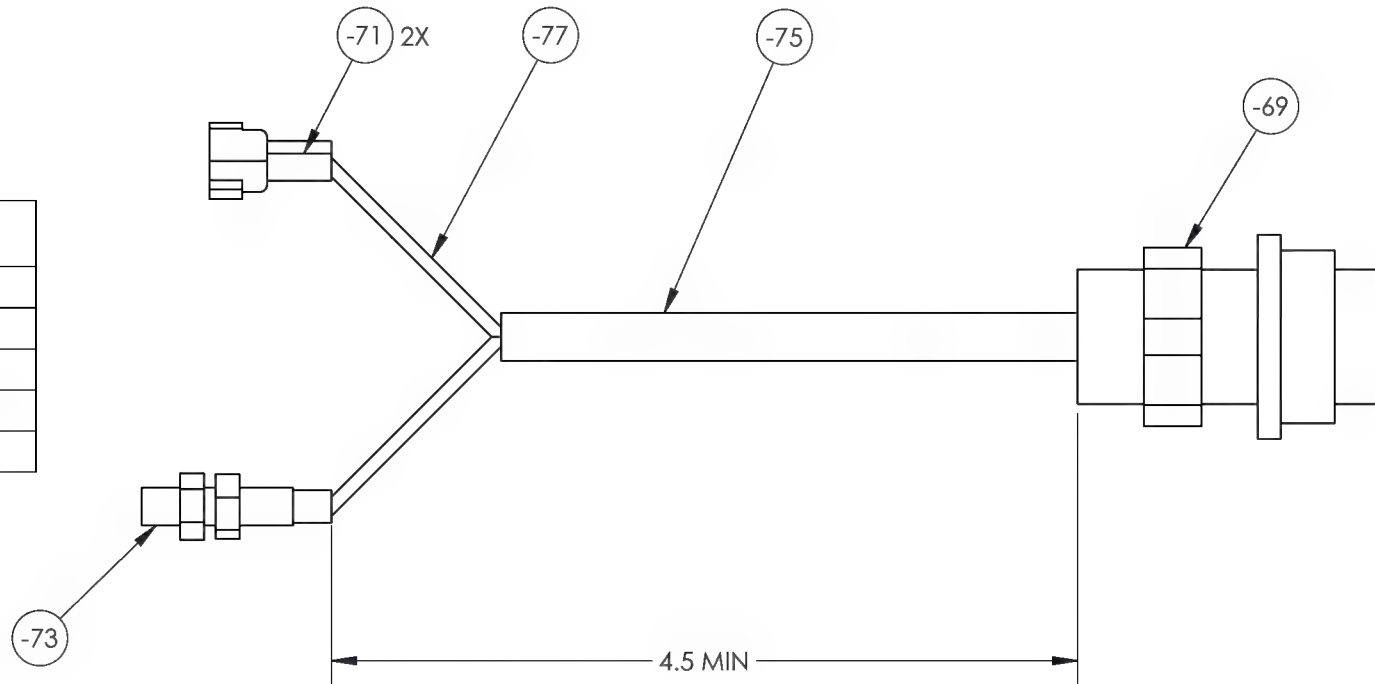


-67
CABLE HARNESS

DART AEROSPACE	
TITLE VERTICAL CAPTURE TRANSPORT	
DWG NO. VCT-3-67	REV 2
MAT'L	DRAWN BY: DUERFELDT
UNLESS OTHERWISE SPECIFIED DIMENSIONS ARE IN INCHES	APPROVED <i>J Gilbert</i>
.XXX ± .005	HEAT
.XX ± .01	TREAT
.X ± .1	FINISH
1. BREAK ALL SHARP EDGES .015 x 45° OR .015R	SPEC
2. DIMENSIONAL LIMITS APPLY AFTER PLATING	USED ON MODEL
SCALE 1:1	DATE 12/4/2014
SHEET 39 OF 57	

This drawing, specifications, and concepts contained here in are the sole property of Dart Aerospace, and may not be reproduced or used in any fashion without the prior written permission of Dart Aerospace Eugene, OR.

REVISIONS			DATE	INITIAL	APPROVED
REV	ECR	DESCRIPTION			
2	15-0149	-79 ADDED 4X -231, 4X -233, 4X -235.	6/23/2015	PMW	JAG

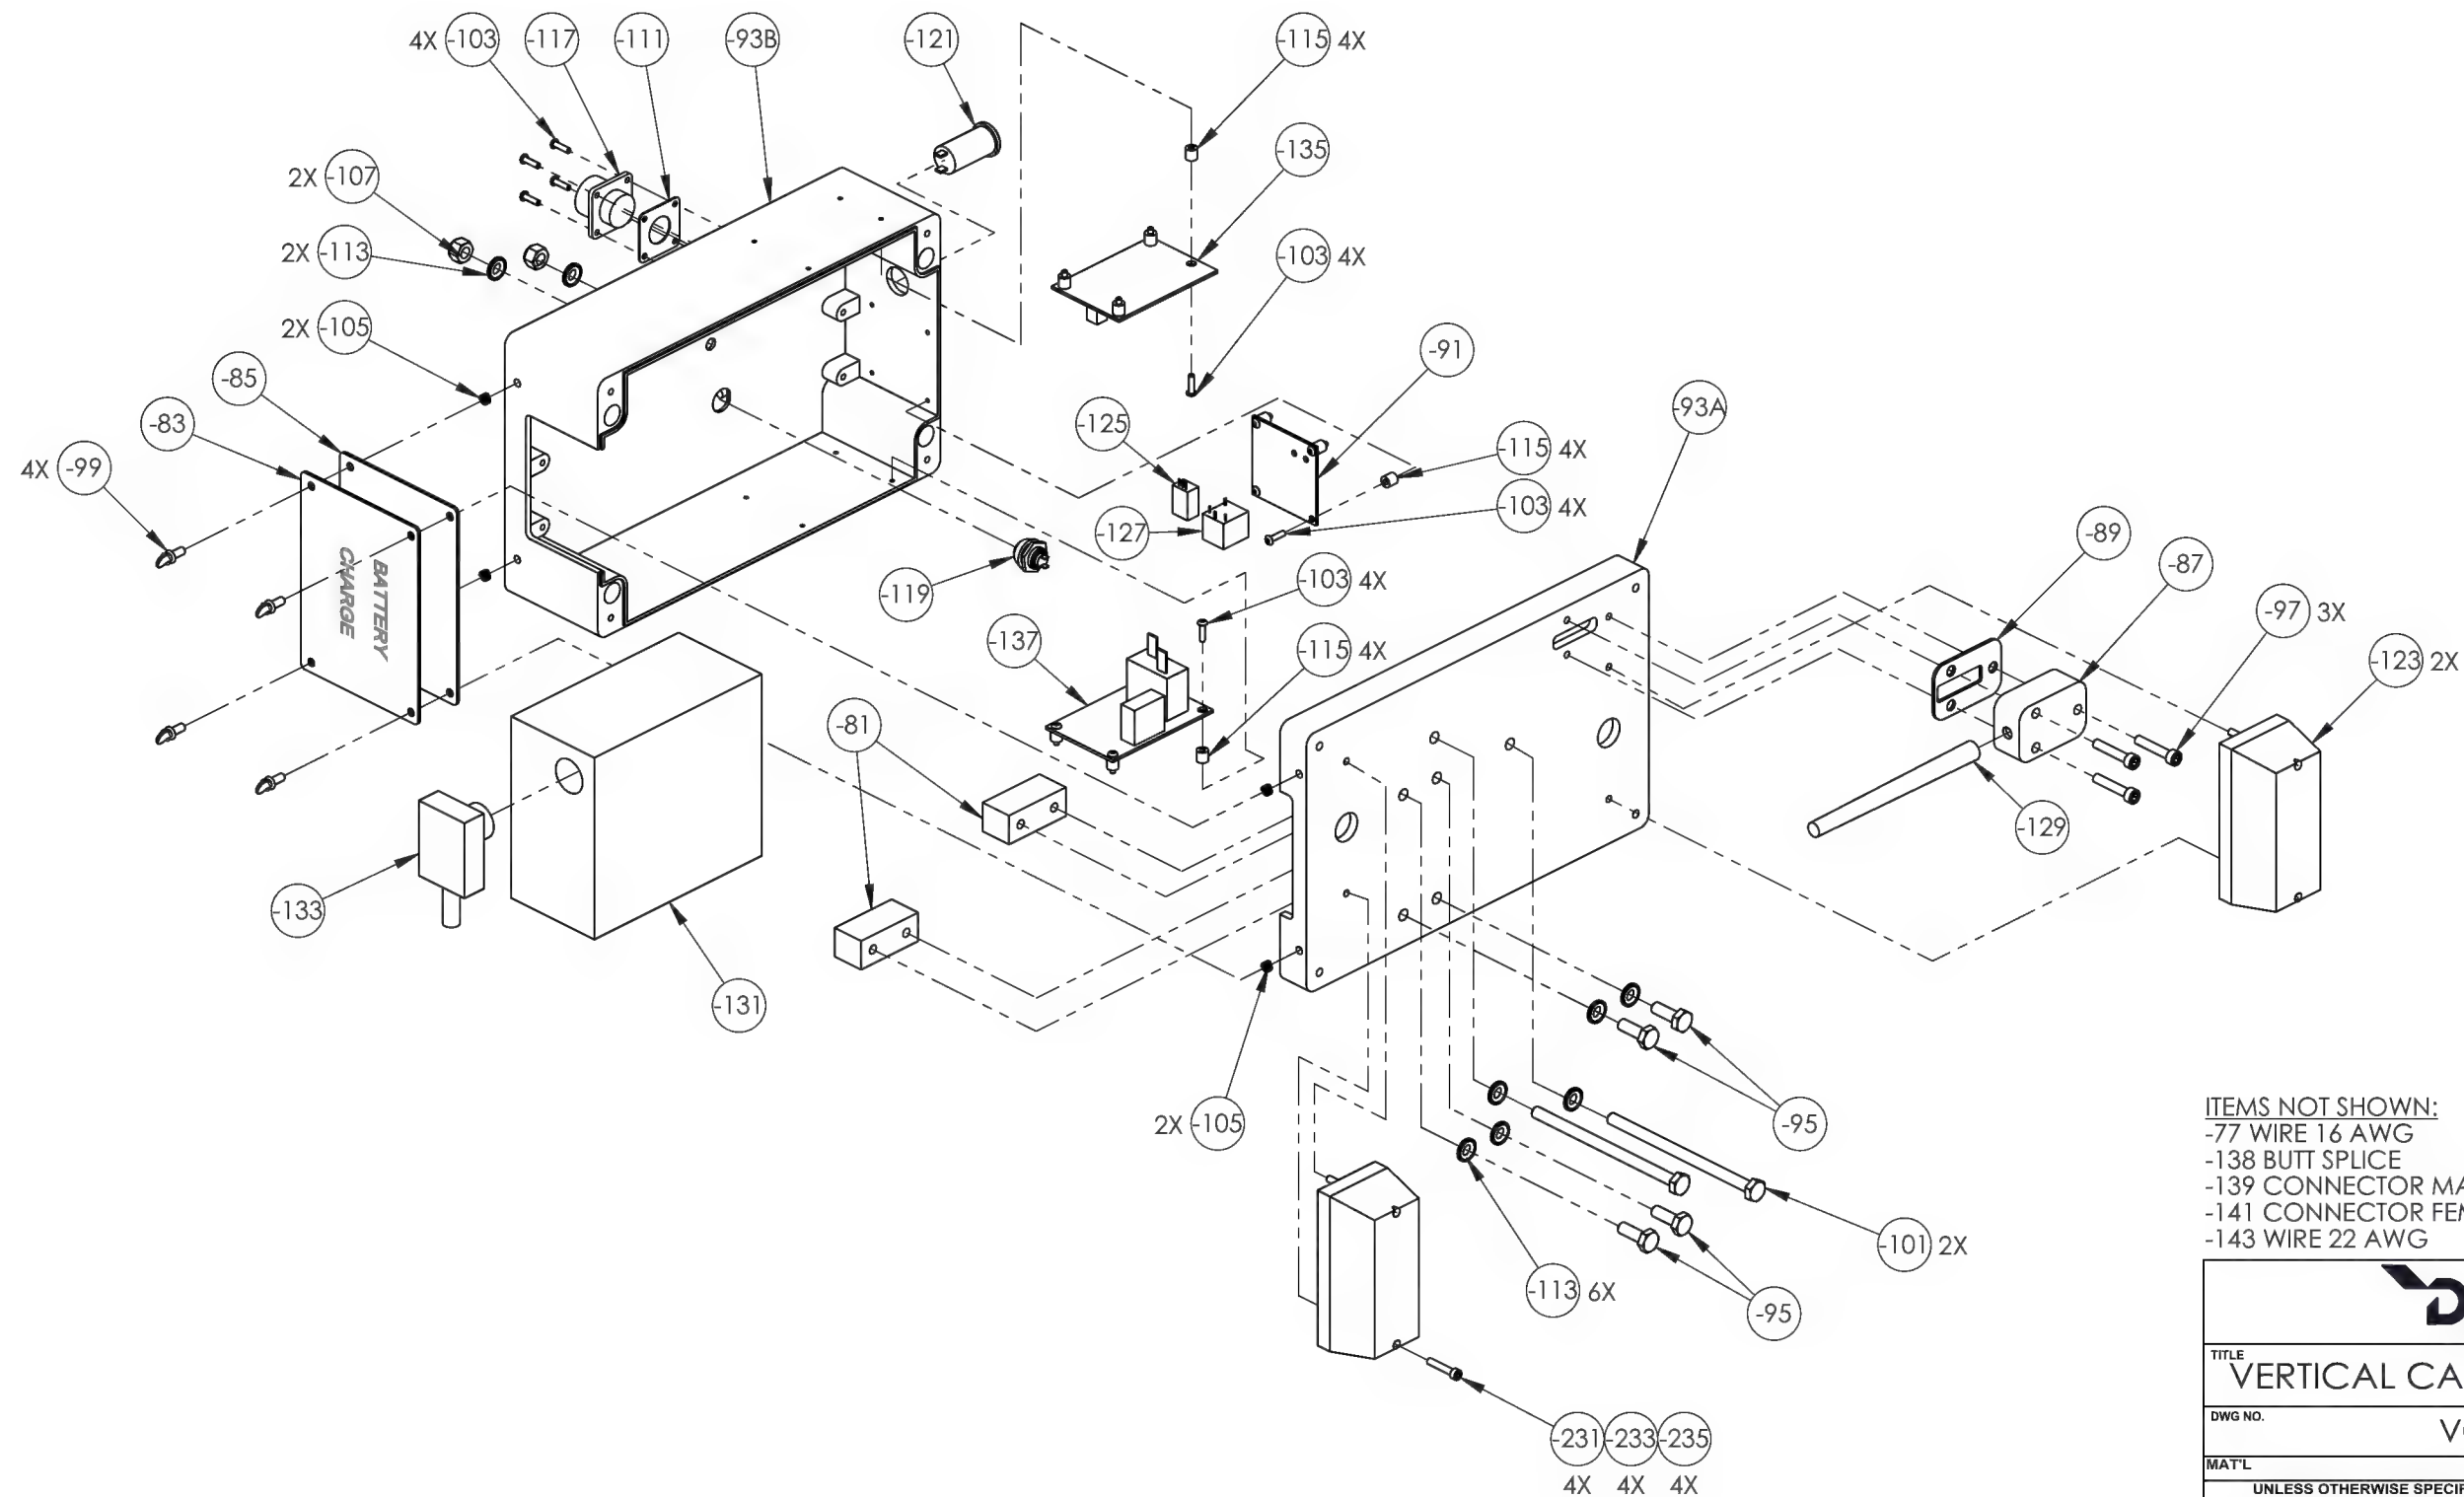

ITEMS NOT SHOWN:
-77 WIRE 16 AWG
-138 BUTT SPLICE
-139 CONNECTOR MALE
-141 CONNECTOR FEMALE
-143 WIRE 22 AWG

DART AEROSPACE		
TITLE VERTICAL CAPTURE TRANSPORT		
DWG NO. VCT-3-79		REV 2
MAT'L	DRAWN BY: DUERFELDT	
UNLESS OTHERWISE SPECIFIED DIMENSIONS ARE IN INCHES .XXX ± .005 FRACTIONS ± 1/8 .XX ± .01 ANGLES ± 5° .X ± .1 1. BREAK ALL SHARP EDGES .015 x 45° OR .015R 2. DIMENSIONAL LIMITS APPLY AFTER PLATING	APPROVED <i>J. Gilbert</i>	
	TREAT FINISH	
	SPEC	
	USED ON MODEL	
SCALE 1:4	DATE 12/4/2014	SHEET 40 OF 57


-79
ELECTRICAL ASSEMBLY

This drawing, specifications, and concepts contained here in are the sole property of Dart Aerospace, and may not be reproduced or used in any fashion without the prior written permission of Dart Aerospace Eugene, OR.

REVISIONS					
REV	ECR	DESCRIPTION	DATE	INITIAL	APPROVED
2	15-0149	-79E UPDATED WIRE TABLE AS BUILT. CH'D T3-T4 QD TO T3 BUTT SPLICE. ADDED T11 BUTT SPLICE. ADDED T12-T13 QD.	6/22/2015	PMW	JAG

WIRE TABLE

WIRE	WIRE TYPE	FROM	TO	LENGTH (IN)
1	PLUG WIRE WHITE	P1	S1-COM	20
2	PLUG WIRE BLACK	P1	T3	18
3	PLUG WIRE BLACK	P2	T1	3
4	16 AWG BLACK	T3	T1	10
5	16 AWG BLACK	T3	T5	3
6	22 AWG BLACK	T3	S1-LED-	10
7	22 AWG BLACK	T3	C1-C	10
8	22 AWG BLACK	T3	R1-5	10
9	16 AWG BLACK	T3	V1-2	10
10	PLUG WIRE RED	P2	T11	8
11	16 AWG RED	T11	C1-A	6
12	16 AWG RED	T11	V1-1	7
13	22 AWG RED	T11	S1-LED+	7
14	16 AWG RED	T11	S1-NO	7
15	16 AWG BLUE	C1-D	R1-1	7
16	16 AWG BLUE	C1-D	V1-3	7
17	16 AWG WHITE	C1-B	T2	8
18	22 AWG PURPLE	C1-E	R1-2	7
19	16 AWG BLUE	T7	R1-3	13
20	22 AWG BLACK	T5	S2-1	13
21	22 AWG YELLOW	T9	S2-2	13
22	LIGHT WIRE BLACK	L1	T6	9
23	LIGHT WIRE BLACK	L2	T6	9
24	LIGHT WIRE RED	L1	T8	9
25	LIGHT WIRE RED	L2	T8	9
26	LIGHT WIRE YELLOW	L1	T10	9
27	LIGHT WIRE YELLOW	L2	T12	4
28	22 AWG YELLOW	T10	T13	9

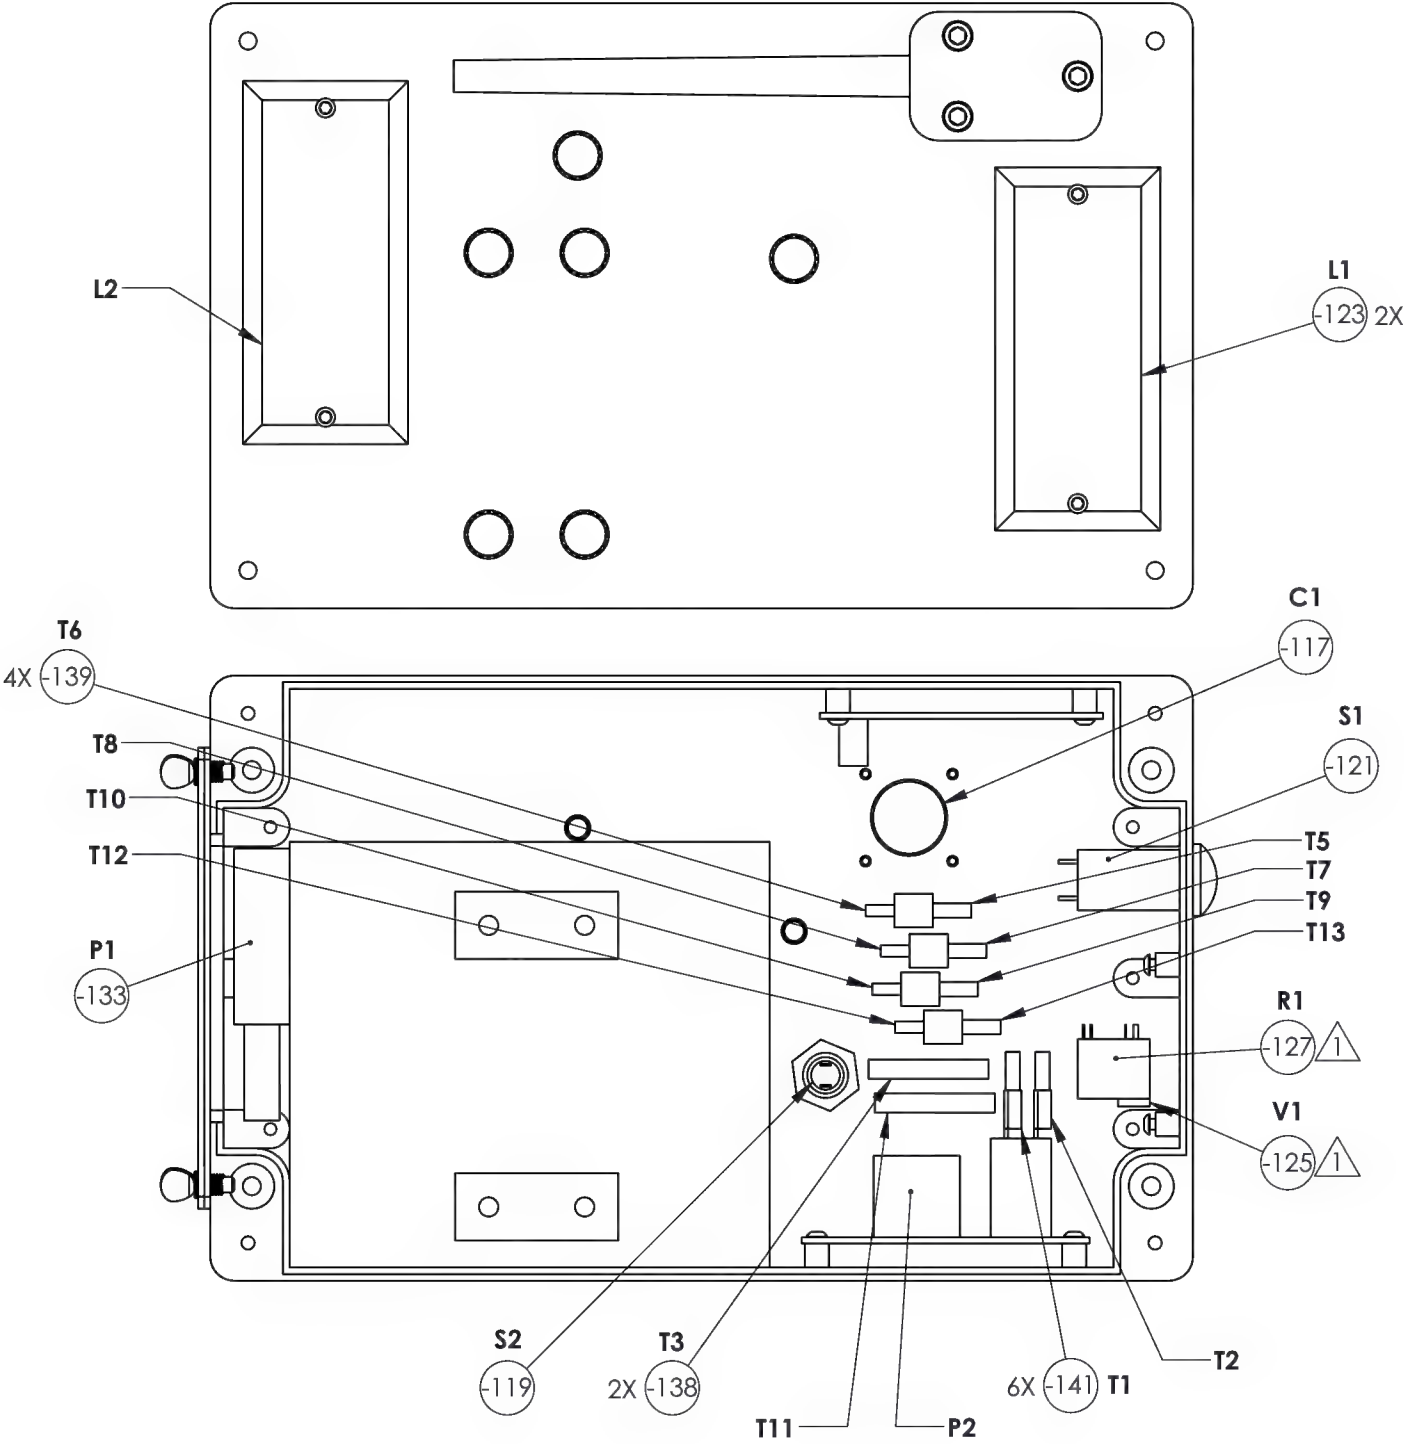

-79E



ELECTRICAL ASSEMBLY
WIRING DIAGRAM

NOTE:
1 REFER TO THE MANUFACTURER SPECIFICATION SHEET FOR CORRECT PINOUT.



DART AEROSPACE		
TITLE VERTICAL CAPTURE TRANSPORT		
DWG NO. VCT-3-79E	REV 2	
MAT'L UNLESS OTHERWISE SPECIFIED DIMENSIONS ARE IN INCHES .XXX ± .005 .XX ± .01 .X ± .1	DRAWN BY: DUERFELDT APPROVED TREAT FINISH SPEC USED ON MODEL	
1. BREAK ALL SHARP EDGES .015 x 45° OR .015R 2. DIMENSIONAL LIMITS APPLY AFTER PLATING	SCALE 1:2 DATE 12/4/2014 SHEET 41 OF 57	

This drawing, specifications, and concepts contained here in are the sole property of Dart Aerospace, and may not be reproduced or used in any fashion without the prior written permission of Dart Aerospace Eugene, OR.

REVISIONS				
REV	ECR	DESCRIPTION	DATE	INITIAL
				APPROVED

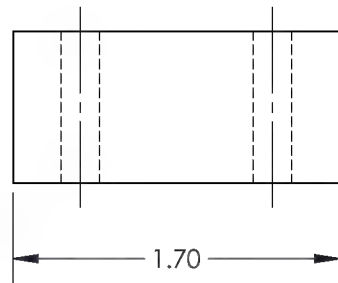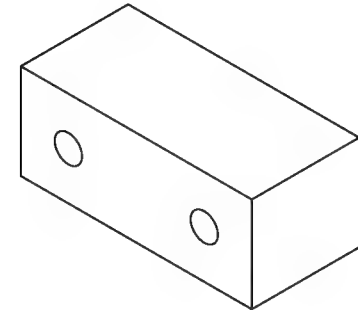

2X 1/4-20 UNC - 2B
THRU ALL

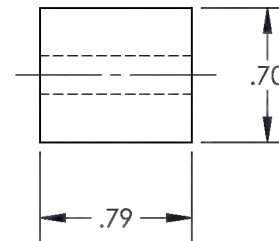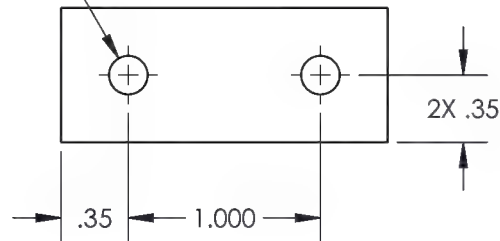




(-81)

BLOCK, BATTERY

DART AEROSPACE	
TITLE VERTICAL CAPTURE TRANSPORT	
DWG NO. VCT-3-81	REV 2
MAT'L 6061	DRAWN BY: CLOUGH
UNLESS OTHERWISE SPECIFIED DIMENSIONS ARE IN INCHES	APPROVED <i>J Gilbert</i>
.XXX ± .005 FRACTIONS ± 1/8	HEAT TREAT
.XX ± .01 ANGLES ± 5°	FINISH CLEAR ANODIZE
.X ± .1	SPEC MIL-A-8625F, TYPE II, CLASS I
1. BREAK ALL SHARP EDGES .015 x 45° OR .015R	USED ON MODEL
2. DIMENSIONAL LIMITS APPLY AFTER PLATING	
SCALE 1:1	DATE 12/3/2014
SHEET 42 OF 57	

This drawing, specifications, and concepts contained here in are the sole property of Dart Aerospace, and may not be reproduced or used in any fashion without the prior written permission of Dart Aerospace Eugene, OR.

REVISIONS			
REV	ECR	DESCRIPTION	DATE
			INITIAL
			APPROVED

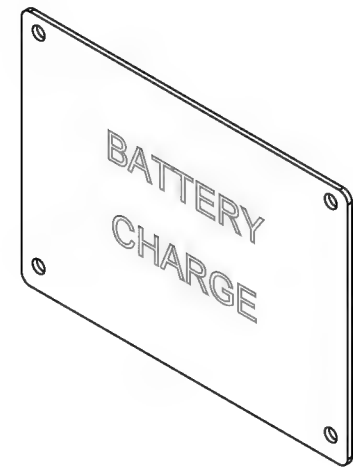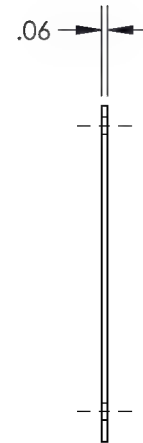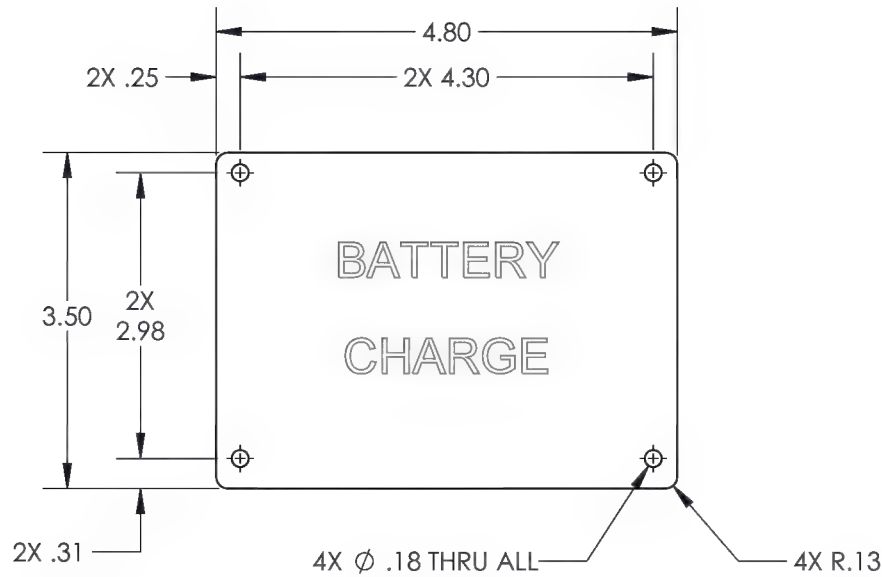

NOTE:
USE PDF FOR LASER ETCHING.




DART AEROSPACE	
TITLE VERTICAL CAPTURE TRANSPORT	
DWG NO. VCT-3-83	REV 2
MAT'L 6061	DRAWN BY: DUERFELDT
UNLESS OTHERWISE SPECIFIED DIMENSIONS ARE IN INCHES	APPROVED <i>J Gilbert</i>
.XXX ± .005	HEAT TREAT
.XX ± .01	FINISH
.X ± .1	CLEAR ANODIZE
1. BREAK ALL SHARP EDGES .015 x 45° OR .015R	SPEC MIL-A-8625F, TYPE II, CLASS I
2. DIMENSIONAL LIMITS APPLY AFTER PLATING	USED ON MODEL
SCALE 1:2	DATE 12/3/2014
SHEET 43 OF 57	

(-83)

ELECTRICAL PORT PLATE

This drawing, specifications, and concepts contained here in are the sole property of Dart Aerospace, and may not be reproduced or used in any fashion without the prior written permission of Dart Aerospace Eugene, OR.

REVISIONS							
REV	ECR	DESCRIPTION			DATE	INITIAL	APPROVED

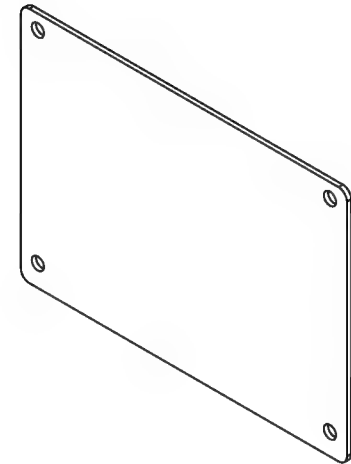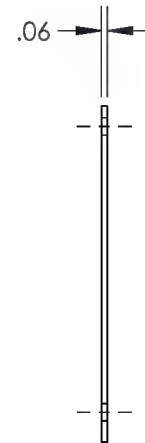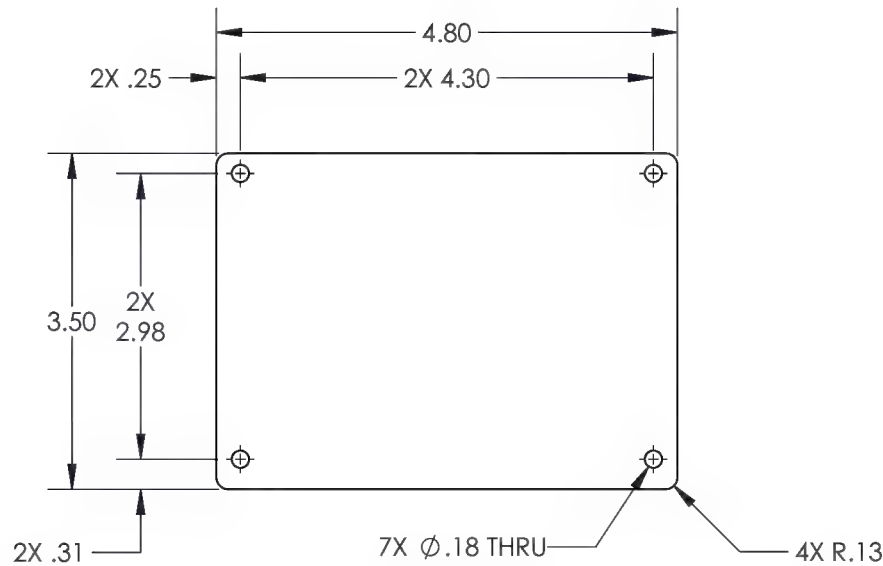



(85)

ELECTRICAL PORT GASKET

DART AEROSPACE	
TITLE VERTICAL CAPTURE TRANSPORT	
DWG NO. VCT-3-85	REV 2
MAT'L NEOPRENE RUBBER	DRAWN BY: DUERFELDT
UNLESS OTHERWISE SPECIFIED DIMENSIONS ARE IN INCHES	APPROVED <i>J Gilbert</i>
.XXX ± .005	HEAT
.XX ± .01	TREAT
.X ± .1	FINISH
1. BREAK ALL SHARP EDGES .015 x 45° OR .015R	SPEC
2. DIMENSIONAL LIMITS APPLY AFTER PLATING	USED ON MODEL
SCALE 1:2	DATE 12/3/2014
SHEET 44 OF 57	

This drawing, specifications, and concepts contained here in are the sole property of Dart Aerospace, and may not be reproduced or used in any fashion without the prior written permission of Dart Aerospace Eugene, OR.


REVISIONS			
REV	ECR	DESCRIPTION	DATE
			INITIAL
			APPROVED

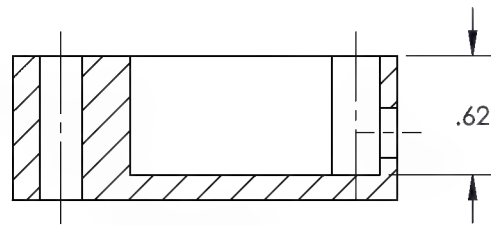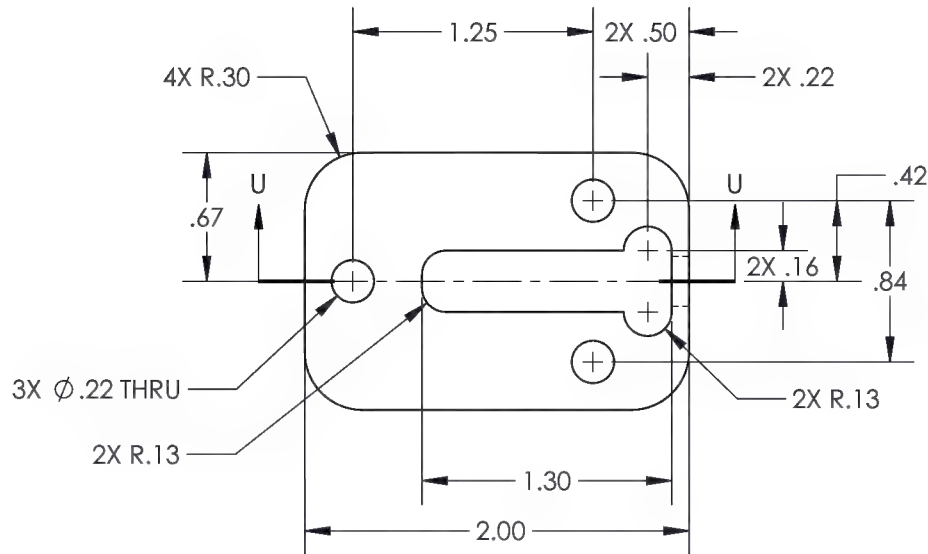

SECTION U-U

(-87)




ANTENNA BLOCK

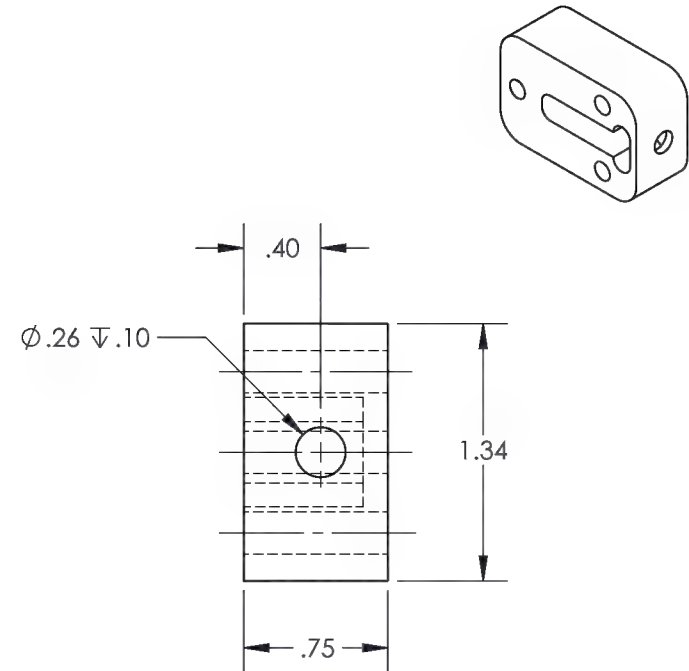

DART AEROSPACE	
TITLE VERTICAL CAPTURE TRANSPORT	
DWG NO. VCT-3-87	REV 2
MAT'L 6061	DRAWN BY: CLOUGH
UNLESS OTHERWISE SPECIFIED DIMENSIONS ARE IN INCHES	APPROVED <i>J Gilbert</i>
.XXX ± .005 FRACTIONS ± 1/8	HEAT TREAT
.XX ± .01 ANGLES ± 5°	FINISH CLEAR ANODIZE
.X ± .1	SPEC MIL-A-8625F, TYPE II, CLASS II
1. BREAK ALL SHARP EDGES .015 x 45° OR .015R	USED ON MODEL
2. DIMENSIONAL LIMITS APPLY AFTER PLATING	
SCALE 1:1	DATE 12/3/2014
SHEET 45 OF 57	

This drawing, specifications, and concepts contained here in are the sole property of Dart Aerospace, and may not be reproduced or used in any fashion without the prior written permission of Dart Aerospace Eugene, OR.

REVISIONS			
REV	ECR	DESCRIPTION	DATE
			INITIAL
			APPROVED

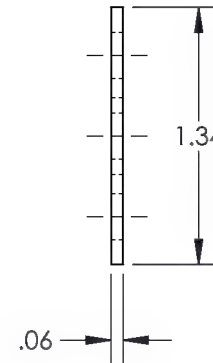
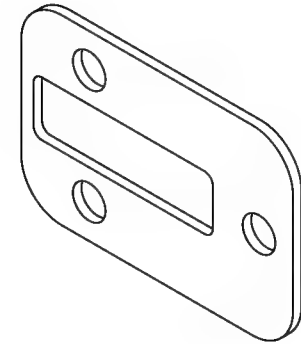
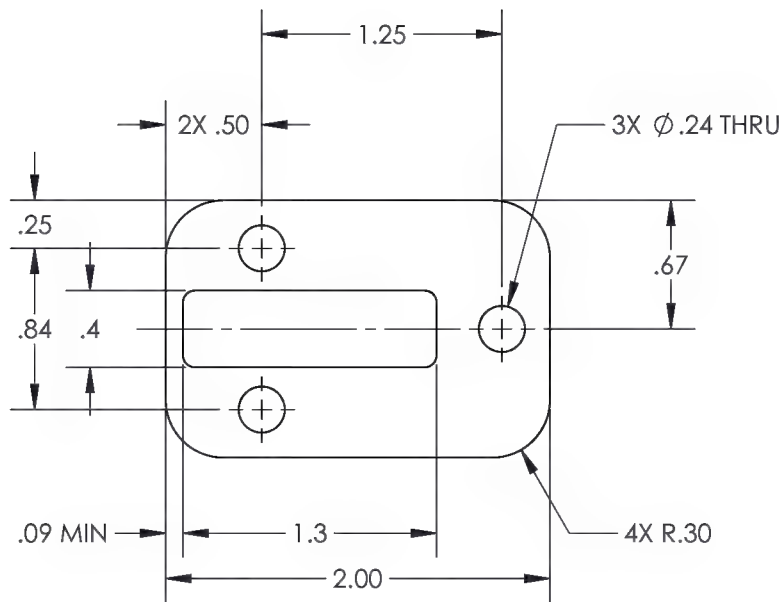


(-89)
GASKET, ANTENNA BLOCK

DART AEROSPACE	
TITLE VERTICAL CAPTURE TRANSPORT	
DWG NO. VCT-3-89	REV 2
MAT'L BUNA-N RUBBER	DRAWN BY: CLOUGH
UNLESS OTHERWISE SPECIFIED DIMENSIONS ARE IN INCHES	APPROVED <i>J Gilbert</i>
.XXX ± .005 FRACTIONS ± 1/8	HEAT
.XX ± .01 ANGLES ± 5°	TREAT
.X ± .1	FINISH
1. BREAK ALL SHARP EDGES .015 x 45° OR .015R	SPEC
2. DIMENSIONAL LIMITS APPLY AFTER PLATING	USED ON MODEL
SCALE 1:1	DATE 12/3/2014
SHEET 46 OF 57	

This drawing, specifications, and concepts contained here in are the sole property of Dart Aerospace, and may not be reproduced or used in any fashion without the prior written permission of Dart Aerospace Eugene, OR.

REVISIONS							
REV	ECR	DESCRIPTION			DATE	INITIAL	APPROVED

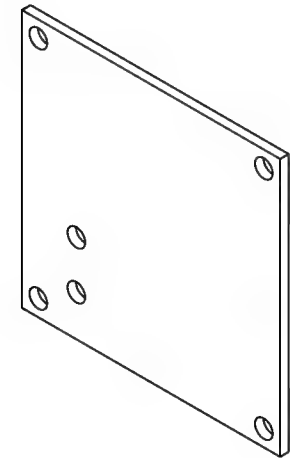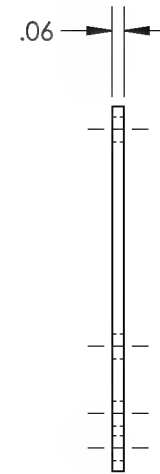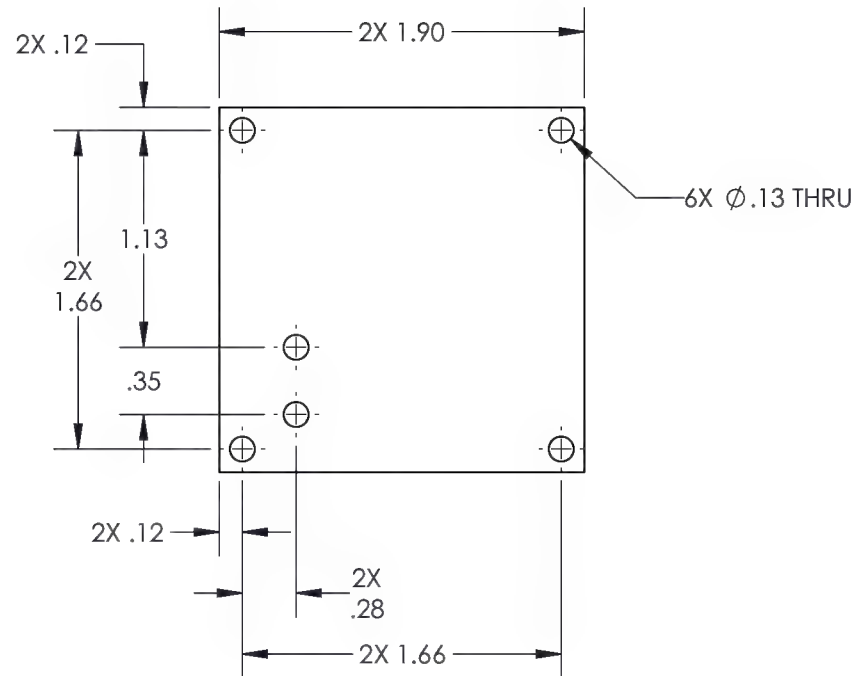




(-91)

PLATE LIGHT ELECTRONICS

DART AEROSPACE	
TITLE VERTICAL CAPTURE TRANSPORT	
DWG NO. VCT-3-91	REV 2
MAT'L 6061	DRAWN BY: DUERFELDT
UNLESS OTHERWISE SPECIFIED DIMENSIONS ARE IN INCHES	APPROVED <i>J Gilbert</i>
.XXX ± .005	HEAT TREAT
.XX ± .01	FINISH
.X ± .1	CLEAR ANODIZE
1. BREAK ALL SHARP EDGES .015 x 45° OR .015R	SPEC MIL-A-8625F, TYPE II, CLASS I
2. DIMENSIONAL LIMITS APPLY AFTER PLATING	USED ON MODEL
SCALE 1:1	DATE 1/3/2014
SHEET 47 OF 57	

This drawing, specifications, and concepts contained here in are the sole property of Dart Aerospace, and may not be reproduced or used in any fashion without the prior written permission of Dart Aerospace Eugene, OR.

REVISIONS					
REV	ECR	DESCRIPTION	DATE	INITIAL	APPROVED
2	15-0149	-93A CH'D HOLE LOCATIONS. A1 WAS 1.20 IS 1.09, A2 WAS 4.20 IS 4.31, A3 WAS 2.10 IS 1.99, A4 WAS 5.10 IS 5.21, C3 WAS 1.56 IS 1.59, C4 WAS 6.00 IS 6.08, CH'D HOLE DIA WAS Ø.13 IS Ø.15.	6/22/2015	PMW	JAG

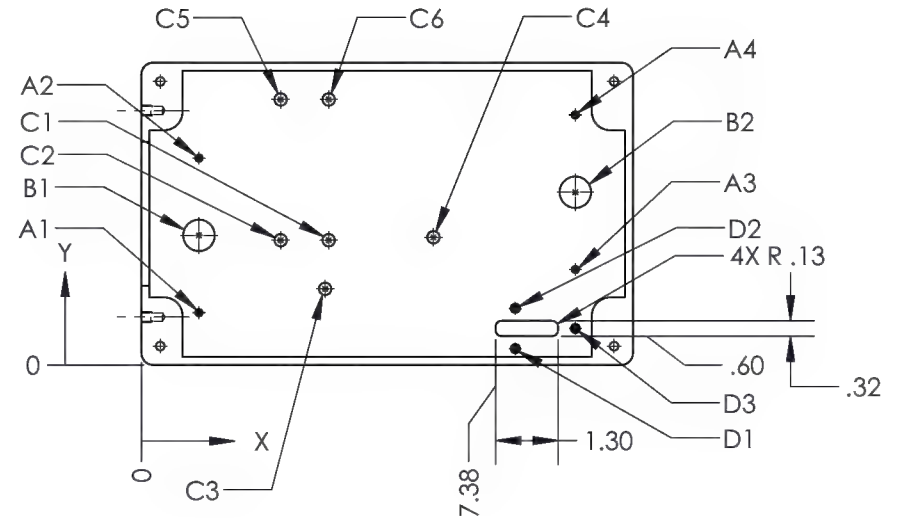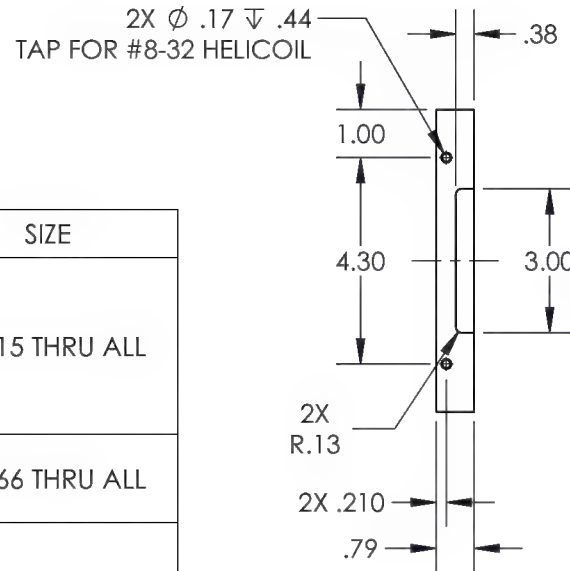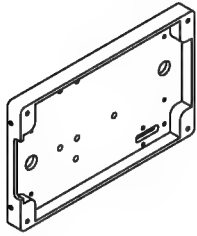

TAG	X LOC	Y LOC	SIZE
A1	1.20	1.09	Ø .15 THRU ALL
A2	1.20	4.31	
A3	9.04	1.99	
A4	9.04	5.21	
B1	1.20	2.70	Ø .66 THRU ALL
B2	9.04	3.60	
C1	3.90	2.60	Ø .26 THRU ALL
C2	2.90	2.60	
C3	3.83	1.59	
C4	6.08	2.66	
C5	2.90	5.53	
C6	3.90	5.53	10-24 UNC - 2B THRU ALL
D1	7.79	.34	
D2	7.79	1.18	
D3	9.04	.76	

NOTE:
SOME HIDDEN LINES OMITTED FOR CLARITY.





DART AEROSPACE	
TITLE VERTICAL CAPTURE TRANSPORT	
DWG NO. VCT-3-93A	REV 2
MAT'L ALUMINUM	DRAWN BY: CLOUGH
UNLESS OTHERWISE SPECIFIED DIMENSIONS ARE IN INCHES	APPROVED <i>J Gilbert</i>
.XXX ± .005	HEAT TREAT
.XX ± .01	FINISH
.X ± .1	SPEC
1. BREAK ALL SHARP EDGES .015 x 45° OR .015R	USED ON MODEL
2. DIMENSIONAL LIMITS APPLY AFTER PLATING	
SCALE 1:4	DATE 12/3/2014
SHEET 48 OF 57	

-93A


LID, ENCLOSURE

This drawing, specifications, and concepts contained here in are the sole property of Dart Aerospace, and may not be reproduced or used in any fashion without the prior written permission of Dart Aerospace Eugene, OR.

REVISIONS					
REV	ECR	DESCRIPTION	DATE	INITIAL	APPROVED
2	15-0149	-93B CH'D HOLE LOCATIONS A1 WAS 1.56 IS 1.59, A2 WAS 4.23 IS 4.15. ADDED MISSING HOLE THREADS 4X 4-40, CH'D HOLE DIM WAS .75 IS .64, CH'D TOL WAS .87 IS .870.	6/22/2015	PMW	JAG

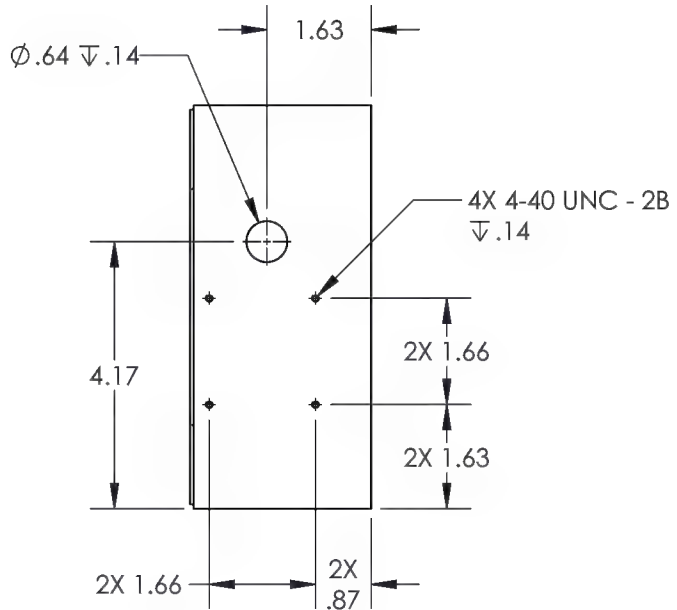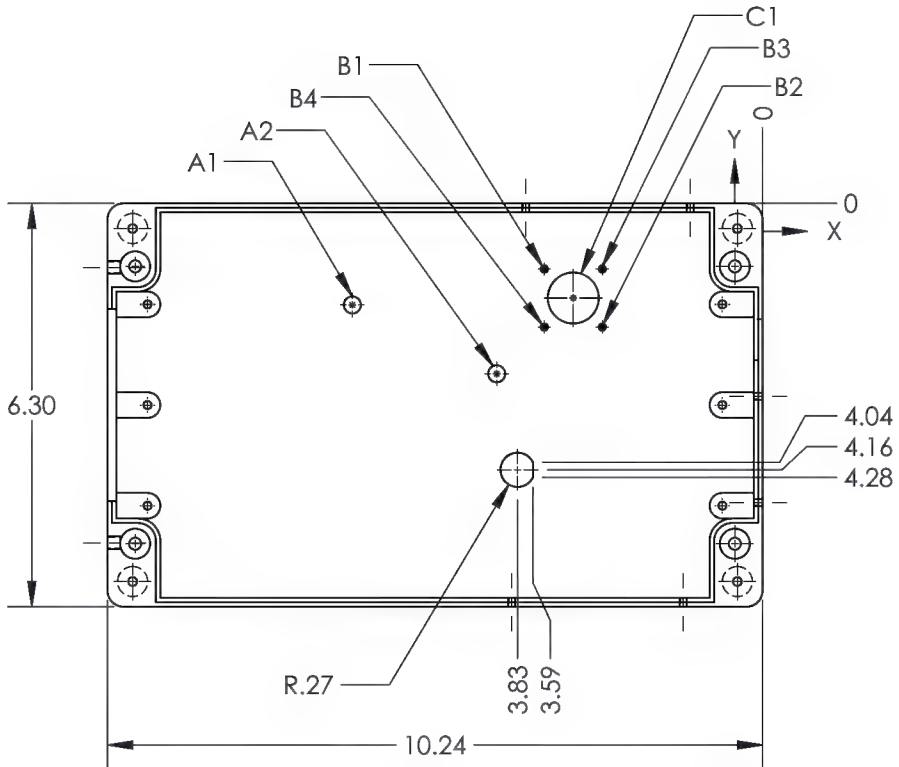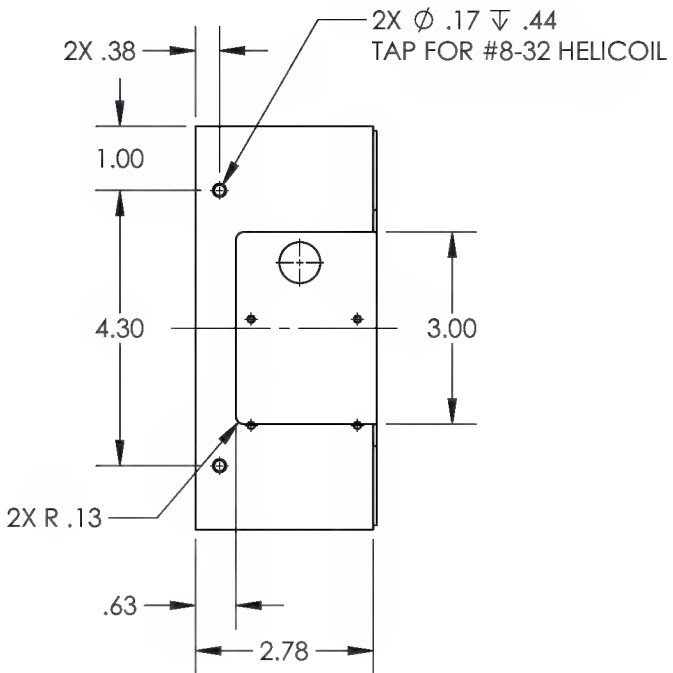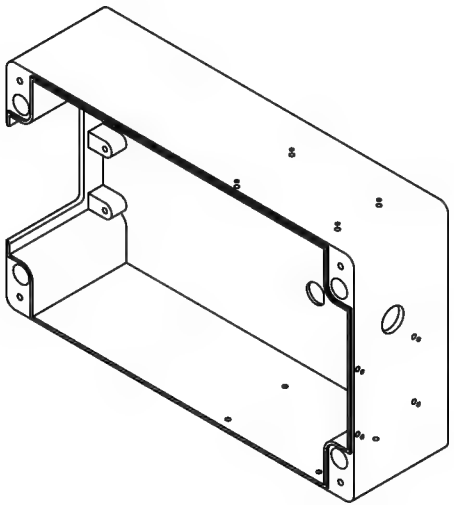

TAG	X LOC	Y LOC	SIZE
A1	-6.41	-1.59	Ø .27 THRU ALL
A2	-4.15	-2.66	
B1	-3.41	-1.03	4-40 UNC - 2B THRU ALL
B2	-2.50	-1.93	
B3	-2.50	-1.03	
B4	-3.41	-1.93	
C1	-2.96	-1.48	Ø .80 THRU ALL

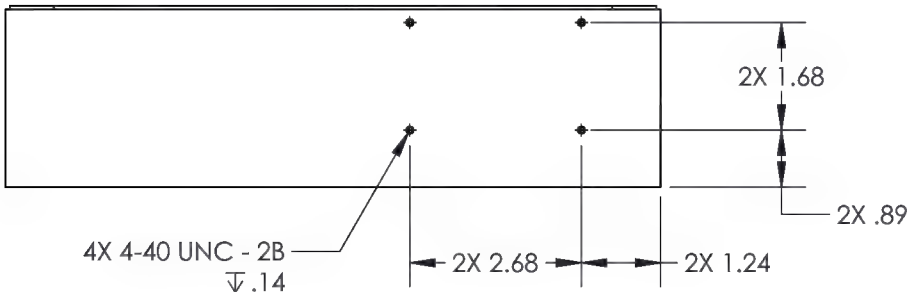

(-93B)

BOX, ENLOSURE

NOTE:
SOME HIDDEN LINES OMITTED FOR CLARITY.



TITLE
VERTICAL CAPTURE TRANSPORT

DWG NO.	VCT-3-93B	P
---------	-----------	---

MAT'L ALUMINUM	DRAWN BY: CLOUGH
----------------	------------------

UNLESS OTHERWISE SPECIFIED DIMENSIONS ARE IN INCHES	APPROVED	<i>J Gilbert</i>
.XXX ± .005	HEAT	
FRACTIONS ± 1/8	TREAT	
.XX ± .01	FINISH	
ANGLES ± 5°		


1. BREAK ALL SHARP EDGES .015 x 45°	SPEC
-------------------------------------	------

2. DIMENSIONAL LIMITS APPLY AFTER PLATING	USED ON MODEL
---	---------------


SCALE	1:3	DATE	12/4/2014	SHEET 49 OF 5
-------	-----	------	-----------	---------------

This drawing, specifications, and concepts contained here in are the sole property of Dart Aerospace, and may not be reproduced or used in any fashion without the prior written permission of Dart Aerospace Eugene, OR.

REVISIONS				
REV	ECR	DESCRIPTION	DATE	INITIAL

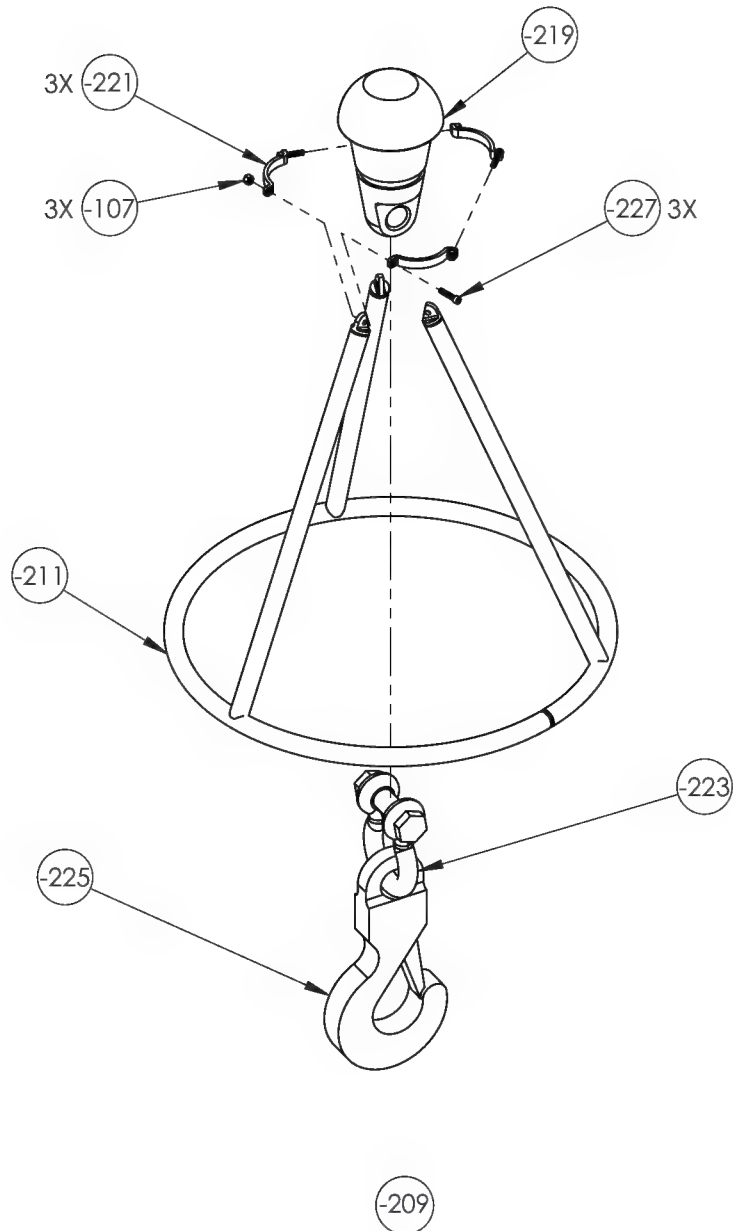




PUCK ASSEMBLY

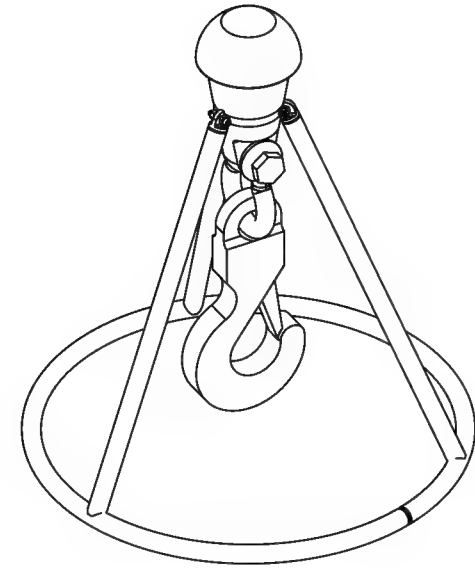

DART AEROSPACE	
TITLE VERTICAL CAPTURE TRANSPORT	
DWG NO. VCT-3-209	REV 2
MAT'L	DRAWN BY: DUERFELDT
UNLESS OTHERWISE SPECIFIED DIMENSIONS ARE IN INCHES	APPROVED <i>J Gilbert</i>
.XXX ± .005	HEAT
.XX ± .01	TREAT
.X ± .1	FINISH
1. BREAK ALL SHARP EDGES .015 x 45° OR .015R	SPEC
2. DIMENSIONAL LIMITS APPLY AFTER PLATING	USED ON MODEL
SCALE 1:10	DATE 12/2/2014
SHEET 50 OF 57	

This drawing, specifications, and concepts contained here in are the sole property of Dart Aerospace, and may not be reproduced or used in any fashion without the prior written permission of Dart Aerospace Eugene, OR.

REVISIONS				
REV	ECR	DESCRIPTION	DATE	INITIAL

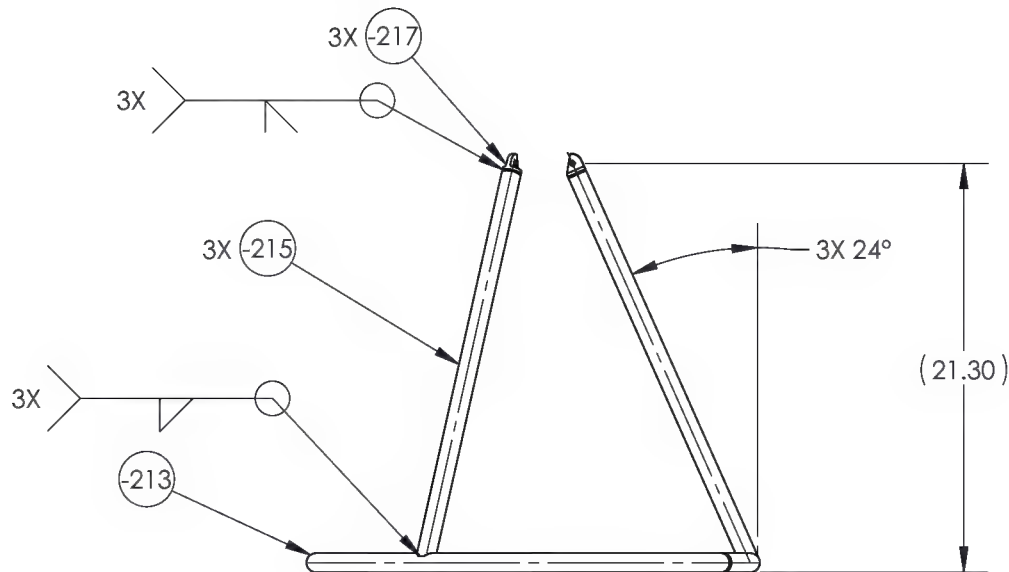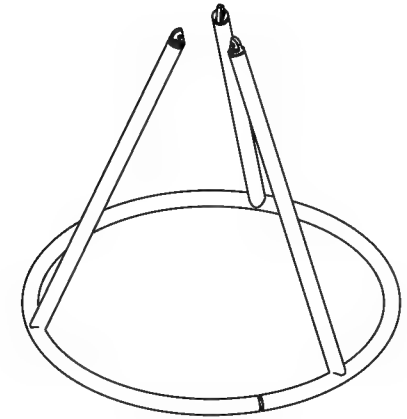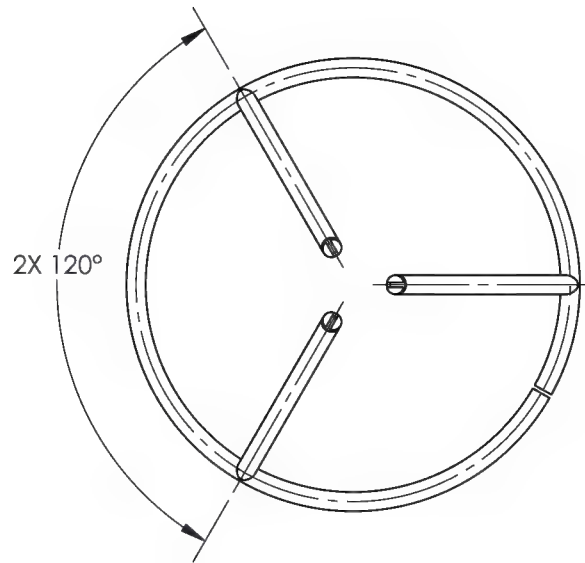


(-211)

PUCK WELDMENT

DART AEROSPACE	
TITLE VERTICAL CAPTURE TRANSPORT	
DWG NO. VCT-3-211	REV 2
MAT'L UNLESS OTHERWISE SPECIFIED DIMENSIONS ARE IN INCHES .XXX ± .005 .XX ± .01 .X ± .1	DRAWN BY: DUERFELDT APPROVED: <i>J Gilbert</i> HEAT TREAT FINISH POWDER COAT RED SPEC RAL 3000 USED ON MODEL
1. BREAK ALL SHARP EDGES .015 x 45° OR .015R 2. DIMENSIONAL LIMITS APPLY AFTER PLATING	
SCALE 1:10	DATE 12/2/2014
SHEET 51 OF 57	

This drawing, specifications, and concepts contained here in are the sole property of Dart Aerospace, and may not be reproduced or used in any fashion without the prior written permission of Dart Aerospace Eugene, OR.

REVISIONS				
REV	ECR	DESCRIPTION	DATE	INITIAL
				APPROVED


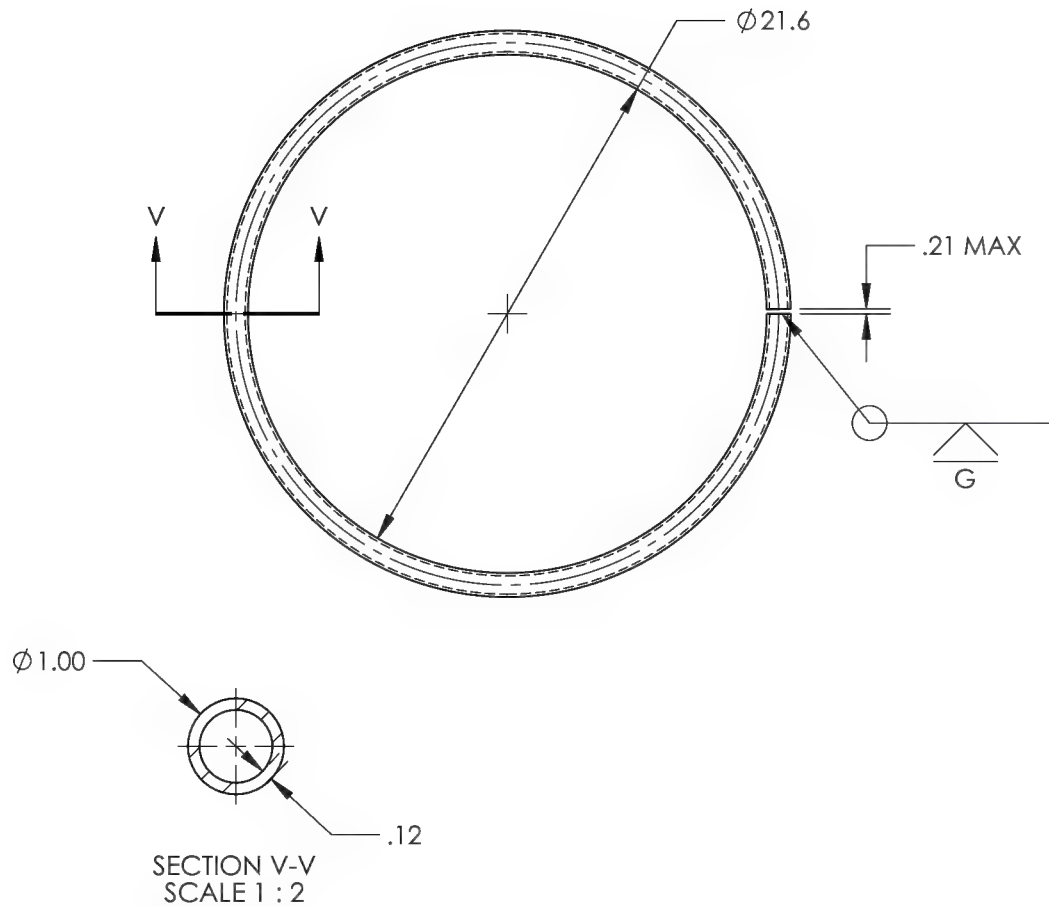


(-213)
PUCK RING

DART AEROSPACE	
TITLE VERTICAL CAPTURE TRANSPORT	
DWG NO. VCT-3-213	REV 2
MAT'L C.D.S. 1018	DRAWN BY: SMITH
UNLESS OTHERWISE SPECIFIED DIMENSIONS ARE IN INCHES	APPROVED <i>J Gilbert</i>
.XXX ± .005 FRACTIONS ± 1/8	HEAT TREAT
.XX ± .01 ANGLES ± 5°	FINISH SEE WELDMENT -211
.X ± .1	SPEC
1. BREAK ALL SHARP EDGES .015 x 45° OR .015R	USED ON MODEL
2. DIMENSIONAL LIMITS APPLY AFTER PLATING	
SCALE 1:8	DATE 10/29/2013
SHEET 52 OF 57	

This drawing, specifications, and concepts contained here in are the sole property of Dart Aerospace, and may not be reproduced or used in any fashion without the prior written permission of Dart Aerospace Eugene, OR.

REVISIONS				
REV	ECR	DESCRIPTION	DATE	INITIAL

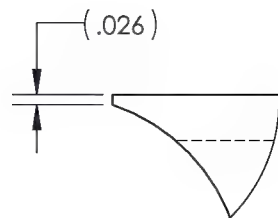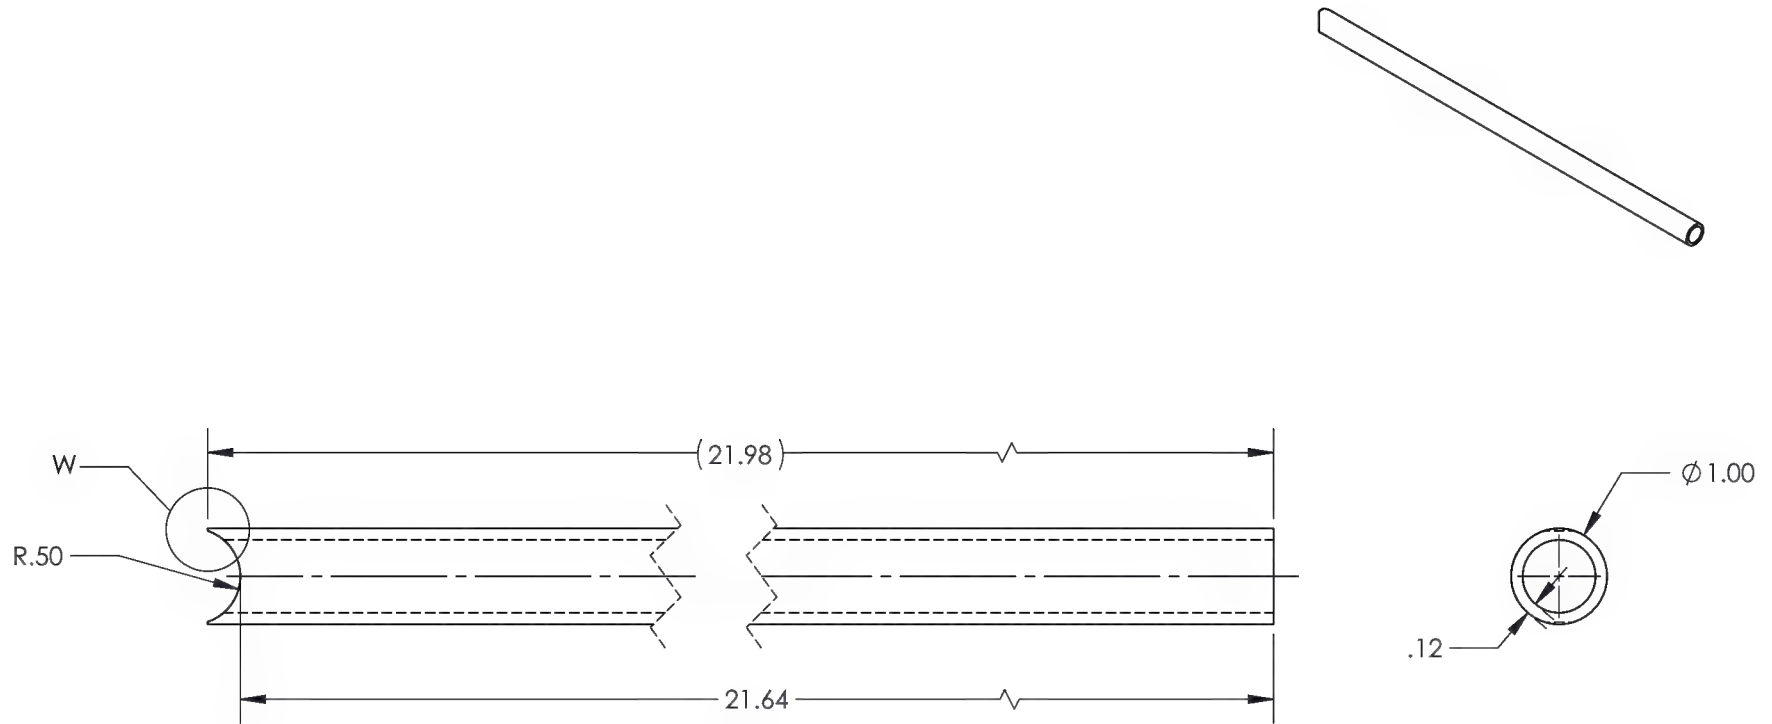

DETAIL W
SCALE 2 : 1





(-215)

PUCK LEG

DART AEROSPACE	
TITLE VERTICAL CAPTURE TRANSPORT	
DWG NO. VCT-3-215	REV 2
MAT'L C.D.S. 1018	DRAWN BY: SMITH
UNLESS OTHERWISE SPECIFIED DIMENSIONS ARE IN INCHES	APPROVED <i>J Gilbert</i>
.XXX ± .005 FRACTIONS ± 1/8	HEAT TREAT
.XX ± .01 ANGLES ± 5°	FINISH SEE WELDMENT -211
.X ± .1	SPEC
1. BREAK ALL SHARP EDGES .015 x 45° OR .015R	USED ON MODEL
2. DIMENSIONAL LIMITS APPLY AFTER PLATING	
SCALE 1:2	DATE 10/29/2013
SHEET 53 OF 57	

This drawing, specifications, and concepts contained here in are the sole property of Dart Aerospace, and may not be reproduced or used in any fashion without the prior written permission of Dart Aerospace Eugene, OR.

REVISIONS				
REV	ECR	DESCRIPTION	DATE	INITIAL
				APPROVED

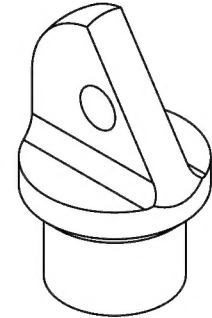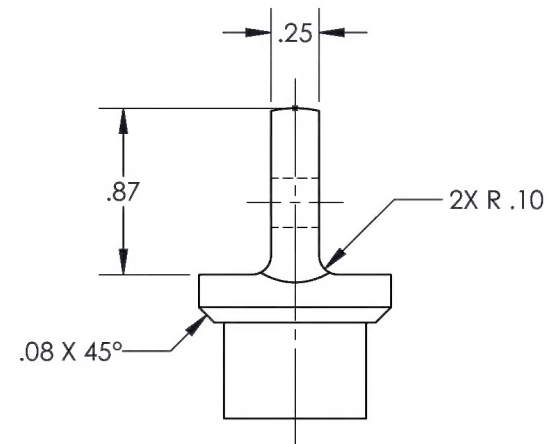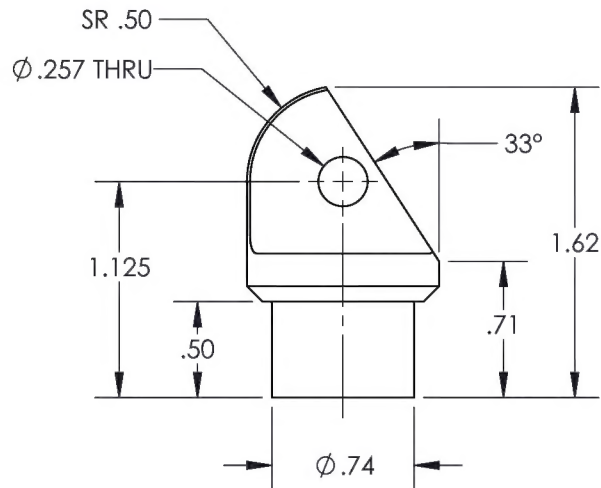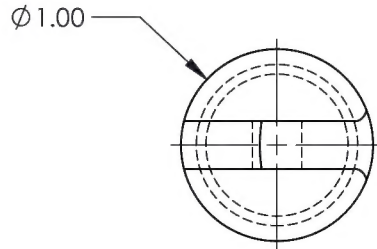


(-217)

PUCK LEG END



DART AEROSPACE	
TITLE VERTICAL CAPTURE TRANSPORT	
DWG NO. VCT-3-217	REV 2
MAT'L 1018	DRAWN BY: SMITH
UNLESS OTHERWISE SPECIFIED DIMENSIONS ARE IN INCHES	APPROVED <i>J Gilbert</i>
.XXX ± .005	HEAT TREAT
.XX ± .01	FINISH SEE WELDMENT -211
.X ± .1	SPEC
1. BREAK ALL SHARP EDGES .015 x 45° OR .015R	USED ON MODEL
2. DIMENSIONAL LIMITS APPLY AFTER PLATING	
SCALE 1:1	DATE 10/29/2013
SHEET 54 OF 57	

This drawing, specifications, and concepts contained here in are the sole property of Dart Aerospace, and may not be reproduced or used in any fashion without the prior written permission of Dart Aerospace Eugene, OR.

REVISIONS					
REV	ECR	DESCRIPTION	DATE	INITIAL	APPROVED
2	15-0149	-219 CH'D TOL WAS .51 IS .510.	6/22/2015	PMW	JAG

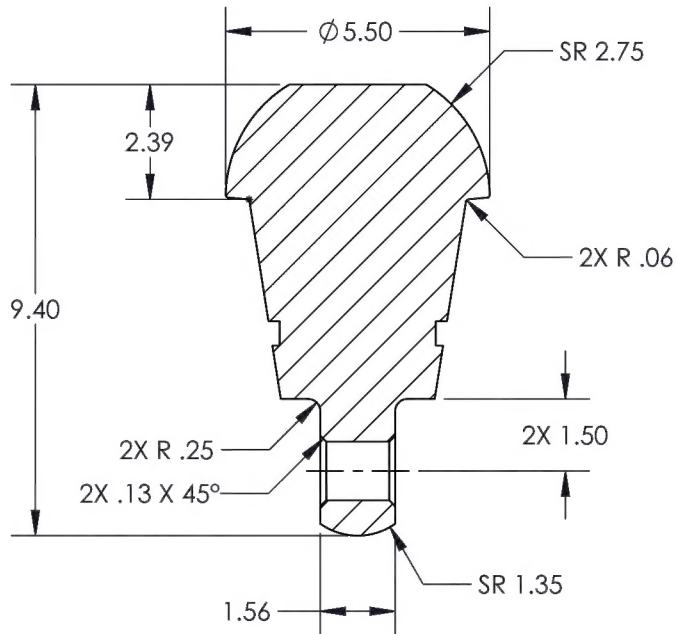

SECTION X-X

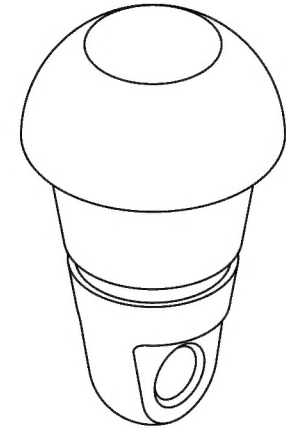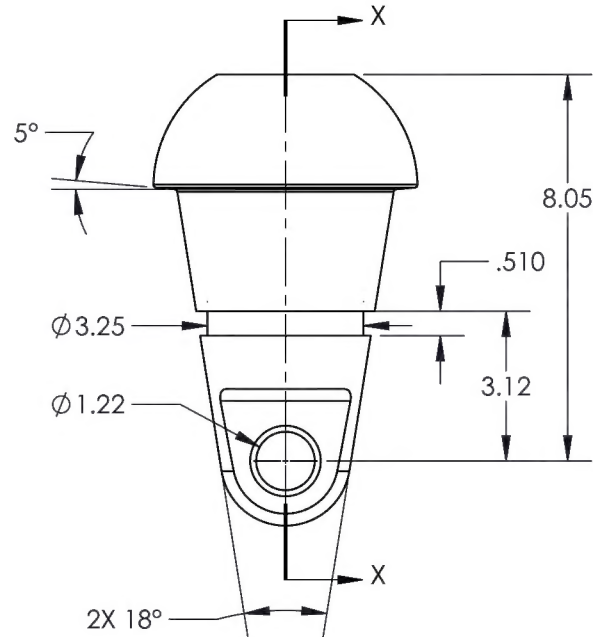

NOTE:
1. NICKEL PLATE .0004 - .0006, BAKE AFTER PLATING.


DART AEROSPACE	
TITLE VERTICAL CAPTURE TRANSPORT	
DWG NO. VCT-3-219	REV 2
MAT'L 4140/4142 Q&T	DRAWN BY: DUERFELDT
UNLESS OTHERWISE SPECIFIED DIMENSIONS ARE IN INCHES	APPROVED <i>J Gilbert</i>
.XXX ± .005	HEAT TREAT
.XX ± .01	FINISH SEE NOTE 1
.X ± .1	SPEC
1. BREAK ALL SHARP EDGES .015 x 45° OR .015R	USED ON MODEL
2. DIMENSIONAL LIMITS APPLY AFTER PLATING	
SCALE 1:4	DATE 12/2/2014
SHEET 55 OF 57	

-219

PUCK ANCHOR

This drawing, specifications, and concepts contained here in are the sole property of Dart Aerospace, and may not be reproduced or used in any fashion without the prior written permission of Dart Aerospace Eugene, OR.

REVISIONS					
REV	ECR	DESCRIPTION	DATE	INITIAL	APPROVED
2	15-0149	-221 CH'D TOL WAS (.50) IS .500.	6/22/2015	PMW	JAG

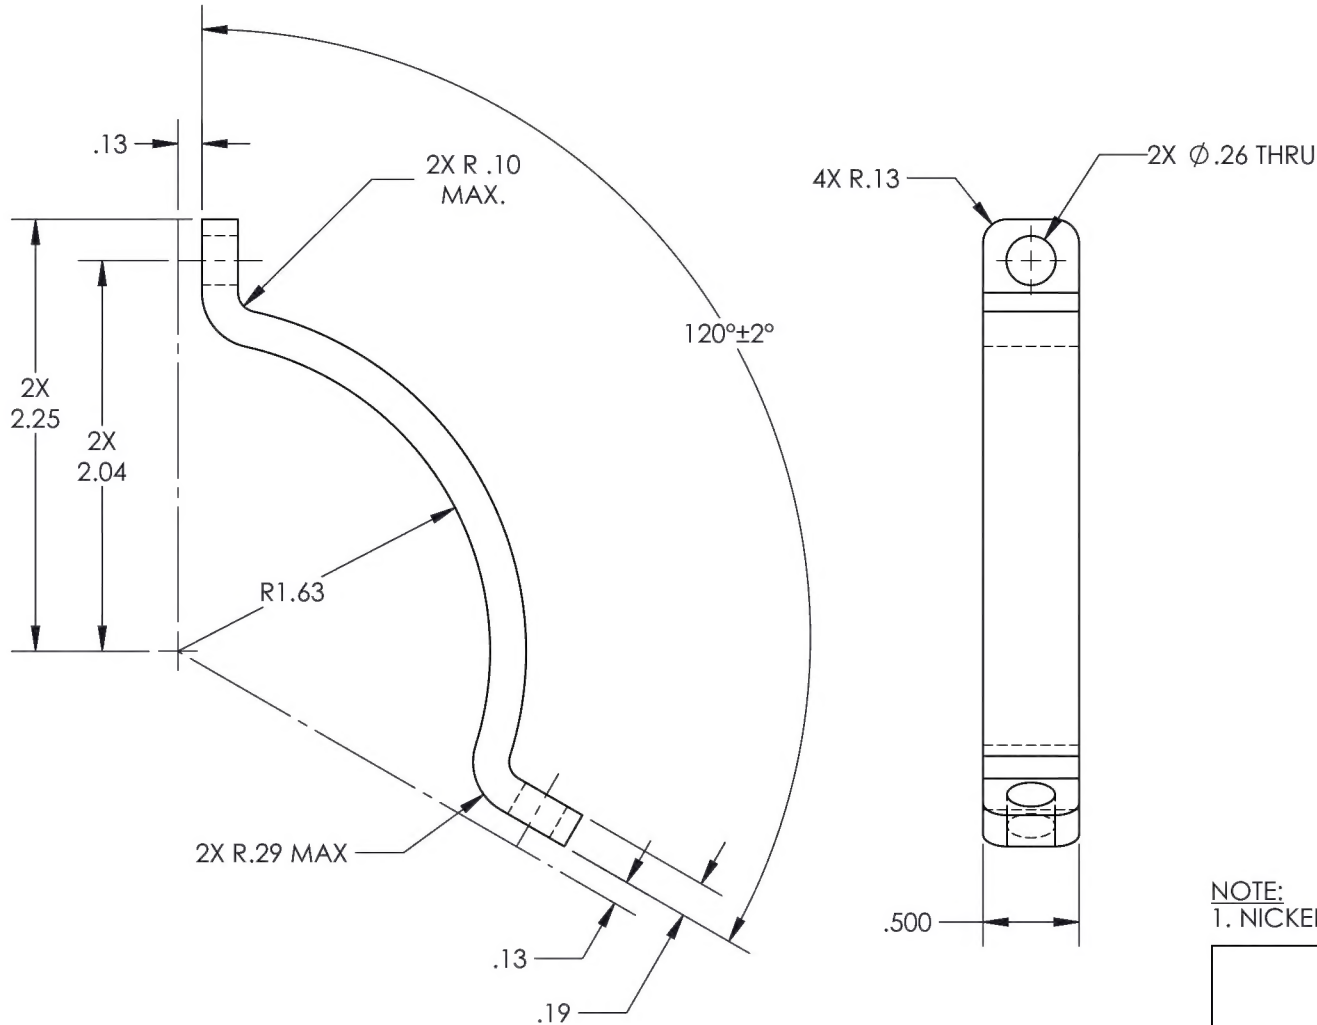

NOTE:
1. NICKEL PLATE .0004 - .0006, BAKE AFTER PLATING.






(-221)

PUCK BRACKET

DART AEROSPACE	
TITLE VERTICAL CAPTURE TRANSPORT	
DWG NO. VCT-3-221	REV 2
MAT'L 4140/4142	DRAWN BY: DUERFELDT
UNLESS OTHERWISE SPECIFIED DIMENSIONS ARE IN INCHES	APPROVED <i>J. Gilbert</i>
.XXX ± .005	HEAT TREAT RC 35-39
.XX ± .01	FINISH SEE NOTE 1
.X ± .1	ANGLES ± 5°
1. BREAK ALL SHARP EDGES .015 x 45° OR .015R	SPEC
2. DIMENSIONAL LIMITS APPLY AFTER PLATING	USED ON MODEL
SCALE 1:1	DATE 12/2/2014
SHEET 56 OF 57	

This drawing, specifications, and concepts contained here in are the sole property of Dart Aerospace, and may not be reproduced or used in any fashion without the prior written permission of Dart Aerospace Eugene, OR.

REVISIONS					
REV	ECR	DESCRIPTION	DATE	INITIAL	APPROVED
2	15-0149	-239 ADDED DRAWING SHHET.	6/24/2015	PMW	JAG

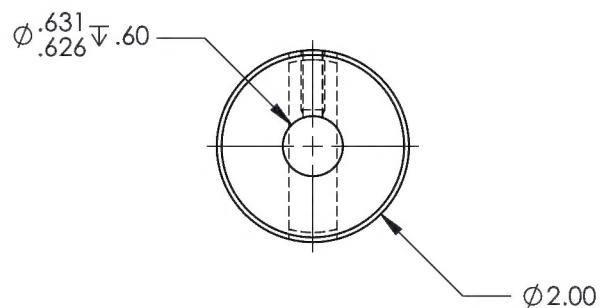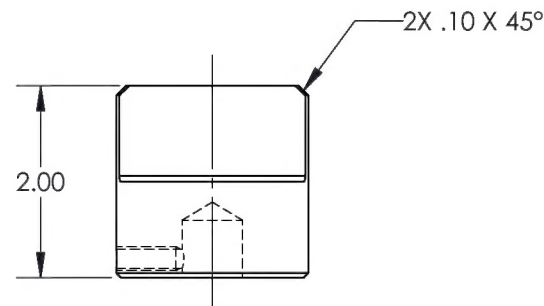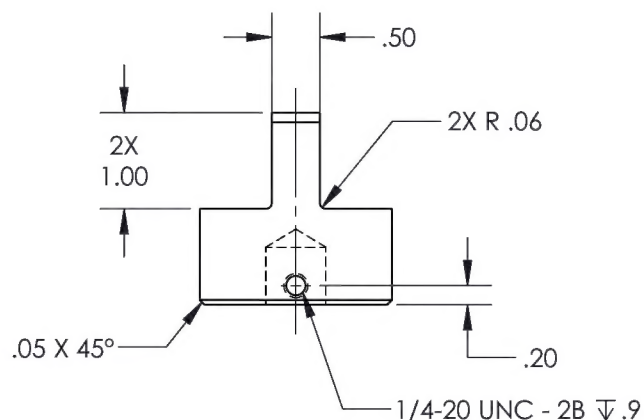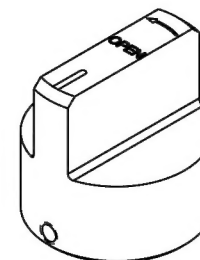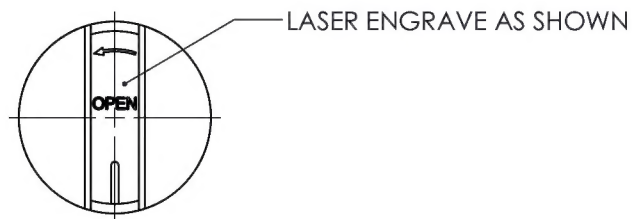

(-239)

MANUAL RELEASE KNOB

DART AEROSPACE	
TITLE VERTICAL CAPTURE TRANSPORT	
DWG NO. VCT-3-239	REV 2
MAT'L 6061	DRAWN BY: WALLRICH
UNLESS OTHERWISE SPECIFIED DIMENSIONS ARE IN INCHES	APPROVED <i>J Gilbert</i>
.XXX ± .005	HEAT TREAT
.XX ± .01	FINISH RED ANODIZE
.X ± .1	SPEC MIL-A-8625F, TYPE II, CLASS II
1. BREAK ALL SHARP EDGES .015 x 45° OR .015R	USED ON MODEL
2. DIMENSIONAL LIMITS APPLY AFTER PLATING	
SCALE 1:2	DATE 6/24/2015
SHEET 57 OF 57	